

National Grid SA-CO **PRODUCTION FILE**

Contractor : ABB Contracting Co.

Project : SS 8709- 132/13.8kV in Alkha

Contract No : 11131113/00

Substation : 8709

**Subject : 132Kv Busbar Protection Set-
Relay Panel-5**

ABB



POWER SYSTEMS NETWORK MANAGEMENT
PROTECTION AND SUBSTATION AUTOMATION SYSTEMS
WBS NO: S-13656

ABB AUTOMATION COMPANY LTD.
414, AL-KHARJ ROAD
SECOND INDUSTRIAL CITY
RIYADH-11383 K.S.A

CONTRACTOR : ABB Contracting Company
CLIENT : National GridSA
PROJECT : CONSTRUCTION OF NEW 132/13.8kV SS 8709 IN AL-KHARJ CITY
SUBSTATION : S/S 8709
CONTRACT NO. : 11131113/00
TITLE : Assembly Drawing - +BBP2-5
[132KV BUSBAR PROTECTION MAIN-2 BAY UNIT PANEL]

AS-BUILT BY _____ DATE _____ CONTRACT NO. 11131113/00 JOB ORDER NO. S-13656

01	13 49	FACTORY ASBUILT	DRAWN BY RIZ	CHECKED BY KVR
00	13 05	FOR APPROVAL	DATE STARTED 30.01.2013	DATE COMPLETED _____
REV. NO.	DATE	DESCRIPTION	OPRG. DEPT. CTPD	ENG. DEPT. AUT-PSAC

COVER SHEET


132KV BUSBAR PROTN.MAIN-2 BU PANEL +BBP2-5
S/S 8709 - 132/13.8KV IN AL-KHARJ CITY
RIYADH SAUDI ARABIA

الشركة الوطنية لنقل الكهرباء



INDEX	PLANT NO.	DRAWING NUMBER	SHEET NO.	REV. NO.
-	C421	CD-323008	SHT 001	01


NG/D2-D (2012/01)
DMS VECTOR NGD200

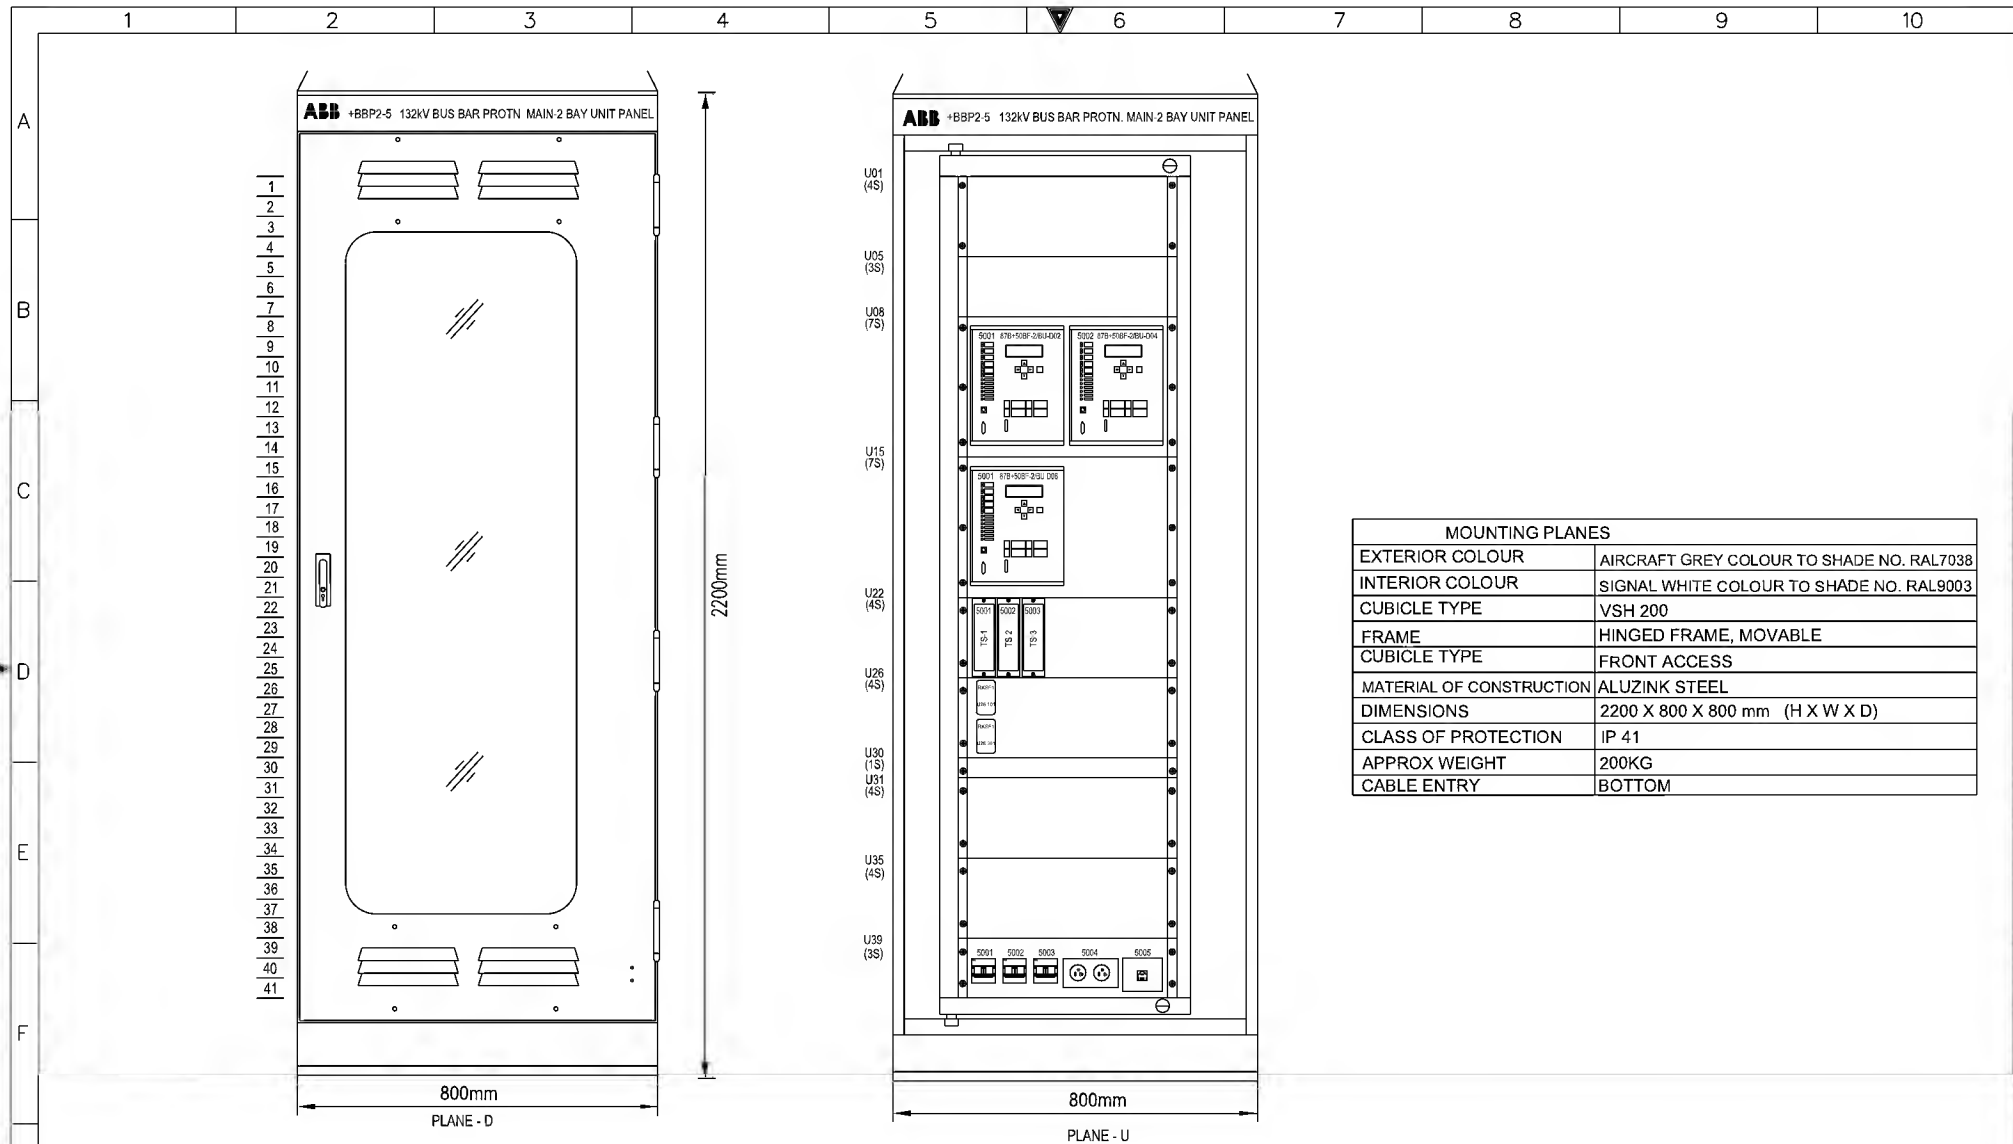

AS-BUILT BY _____ DATE _____		CONTRACT NO. 1113113/00	JOB ORDER NO. S-13656	ASSEMBLY DRAWING		الشركة الوطنية لنقل الكهرباء		نقل الكهرباء	
01	13 49	FACTORY ASBUILT		DRAWN BY RIZ	CHECKED BY KVR	132KV BUSBAR PROTN.MAIN-2 BU PANEL +BBP2-5		National Grid sa	
00	13 05	FOR APPROVAL		DATE STARTED 30.01.2013 DATE COMPLETED _____		S/S 8709 - 132/13.8KV IN AL-KHARJ CITY		INDEX PLANT NO. DRAWING NUMBER SHEET NO. REV. NO.	
REV. NO.	DATE	DESCRIPTION		PRG. DEPT. CTPD ENG. DEPT. AUT-PSAC		RIYADH SAUDI ARABIA		- C421 CD-323008 001 002 01	

NG/D2-D (2012/01)
DMS VECTOR NGD200

THIS DRAWING AND THE INFORMATION CONTAINED HEREIN ARE THE SOLE PROPERTY OF National Grid sa. NO REPRODUCTION IN FULL OR IN PART SHALL BE OBTAINED FROM THIS DOCUMENT WITHOUT THE WRITTEN CONSENT OF ITS OWNER.

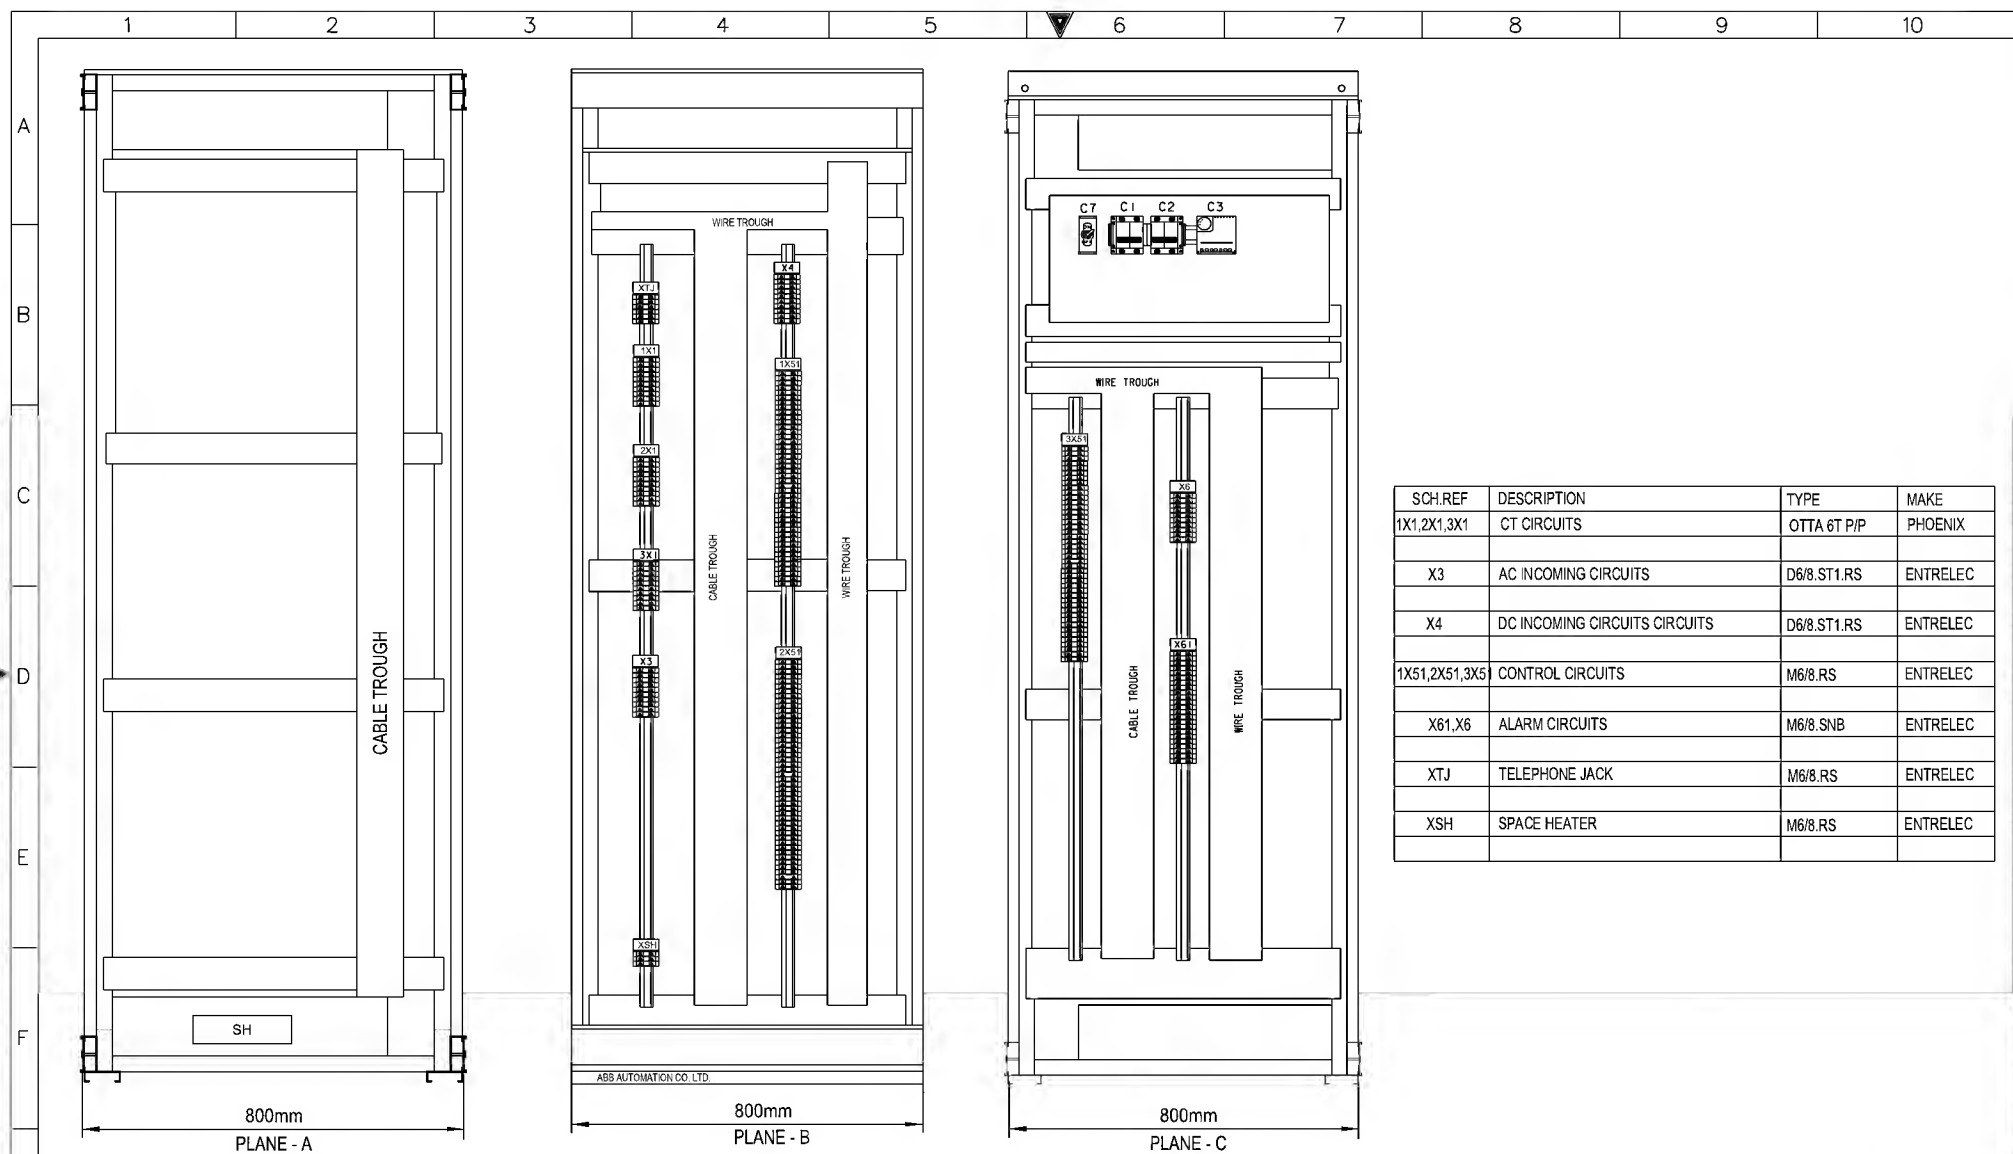

SCH.REF	DESCRIPTION	TYPE	MAKE
1X1,2X1,3X1	CT CIRCUITS	OTTA 6T P/P	PHOENIX
X3	AC INCOMING CIRCUITS	D6/8.ST1.RS	ENTRELEC
X4	DC INCOMING CIRCUITS CIRCUITS	D6/8.ST1.RS	ENTRELEC
1X51,2X51,3X51	CONTROL CIRCUITS	M6/8.RS	ENTRELEC
X61,X6	ALARM CIRCUITS	M6/8.SNB	ENTRELEC
XTJ	TELEPHONE JACK	M6/8.RS	ENTRELEC
XSH	SPACE HEATER	M6/8.RS	ENTRELEC

AS-BUILT BY _____ DATE _____

CONTRACT NO. 11131113/00

JOB ORDER NO. S-13656

0113 49FACTORY ASBUILT

0013 05FOR APPROVAL

REV. NO. DATE DESCRIPTION

DRAWN BY RIZ

CHECKED BY KVR

DATE STARTED 30.01.2013

DATE COMPLETED _____

OPRG. DEPT. CTPD

ENG. DEPT. AUT-PSAC


ASSEMBLY DRAWING

132KV BUSBAR PROTN.MAIN-2 BU PANEL +BBP2-5

S/S 8709 - 132/13.8KV IN AL-KHARJ CITY

RIYADH SAUDI ARABIA

الشركة الوطنية لنقل الكهرباء



National Grid sa

INDEX

PLANT NO.

DRAWING NUMBER

SHEET NO.

SHT |CONT|

REV. NO.


-

C421

CD-323008

G02|G03

01

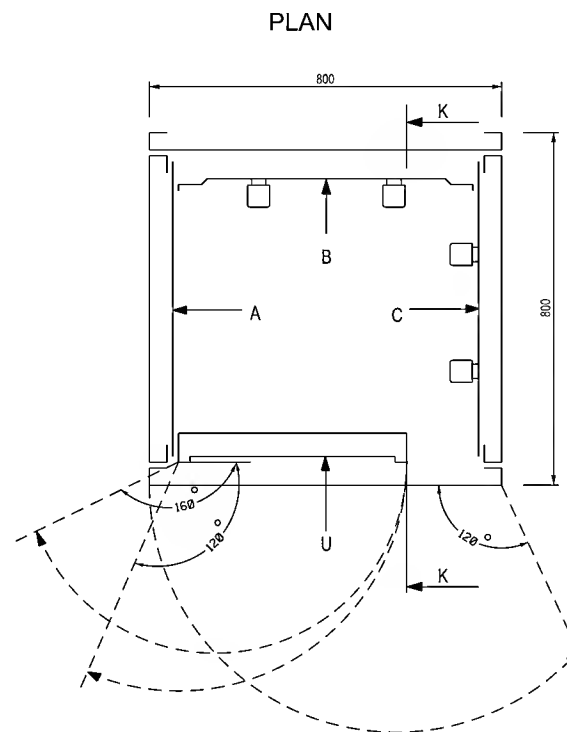

NG/D2-D (2012/01)

DMS	VECTOR	NGD200
-----	--------	--------

1 2 3 4 5 6 7 8 9 10

A

B

C

D


E

F




TOP VIEW FOR EARTHING BAR

U PLANE TOP LABEL

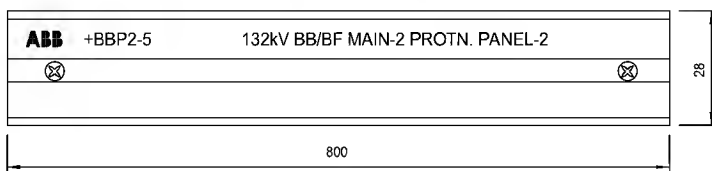

U PLANE BOTTOM LABEL

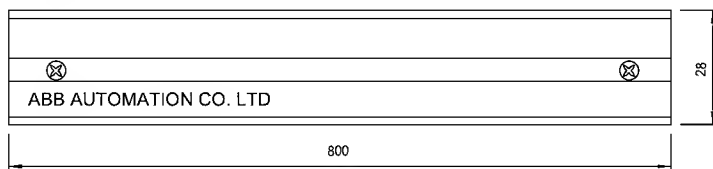

MANUFACTURING LABEL

ABB ABB Automation Co.Ltd.	
PROJECT :	National Grid SA S/S 8709
ORDER REFERENCE :	2875 RF S13656
YEAR OF MANUFACTURE:	2013
PANEL NO. :	+BBP2-5
DRAWING NO. :	S13656-CD-323009
MADE IN THE KINGDOM OF SAUDI ARABIA	

G

AS-BUILT BY _____ DATE _____		CONTRACT NO. 11131113/00	JOB ORDER NO. S-13656	ASSEMBLY DRAWING		الشركة الوطنية لنقل الكهرباء		نقل الكهرباء			
01 13 49		FACTORY ASBUILT		DRAWN BY RIZ CHECKED BY KVR		132KV BUSBAR PROTN.MAIN-2 BU PANEL +BBP2-5		National Grid sa			
00 13 05		FOR APPROVAL		DATE STARTED 30.01.2013 DATE COMPLETED _____		S/S 8709 - 132/13.8KV IN AL-KHARJ CITY		SHT CONT.			
REV. NO.	DATE	DESCRIPTION	OPRG. DEPT. CTPD	ENG. DEPT. AUT-PSAC	RIYADH	SAUDI ARABIA	INDEX -	PLANT NO. C421	DRAWING NUMBER CD-323008	SHEET NO. G04 L00	REV. NO. 01





POWER SYSTEMS NETWORK MANAGEMENT
PROTECTION AND SUBSTATION AUTOMATION SYSTEMS
WBS NO: S-13656

ABB AUTOMATION COMPANY LTD
414, AL-KHARJ ROAD
SECOND INDUSTRIAL CITY
RIYADH-11383 K.S.A

CONTRACTOR : ABB Contracting Company
CLIENT : National Gridsa
PROJECT : CONSTRUCTION OF NEW 132/13.8kV SS 8709 IN AL-KHARJ CITY
SUBSTATION : S/S 8709
CONTRACT NO. : 11131113/00
TITLE : LIST OF APPARATUS - +BBP2-5
[132KV BUSBAR PROTECTION MAIN-2 BAY UNIT PANEL]

AS-BUILT BY _____ DATE _____ CONTRACT NO. 11131113/00 JOB ORDER NO. S-13656

01	13 49	FACTORY ASBUILT	DRAWN BY RIZ	CHECKED BY KVR
00	13 05	FOR APPROVAL	DATE STARTED 30.01.2013	DATE COMPLETED _____
REV. NO.	DATE	DESCRIPTION	OPRG. DEPT. CTPD	ENG. DEPT. AUT-PSAC

COVER SHEET

32KV BUSBAR PROTN.MAIN-2 BU PANEL +BBP2-5
S/S 8709 - 132/13.8KV IN AL-KHARJ CITY
RIYADH SAUDI ARABIA

الشركة الوطنية لنقل الكهرباء



نقل الكهرباء
National Grid sa

INDEX	PLANT NO.	DRAWING NUMBER	SHEET NO.	REV. NO.
-	C421	CD-323008	SHT CONT. L00 L01	01

NG/D2-D (2012/01)

DMS

VECTOR

NGD200

	1	2	3	4	5	6	7	8	9	10
A	SR. NO.	GA. REF.	SCH. REF.	DESCRIPTION		SHT.	QTY.	TYPE	MAKE	ORDERING INFORMATION
	1	U08.5001	87B+50BF-2/BU-D02	RELAY CUBICLE- +BBP2-5 FOR 132KV 5B/BF MAIN-2 ACCOMODATING THE FOLLOWING			3	VSH 200	ABB	
		U08.5002	87B+50BF-2/BU-D04	BAY UNIT FOR NUMERICAL BUSBAR PROTECTION WITH FOLLOWING		293,294		7SS523	SIEMENS	7SS5231-5CA01+1AA1-2/GG
		U15.5001	87B+50BF-2/BU-D06	HIGH TROUGH-FAULT STABILITY EVEN IN CASE OF CT SATURATION.		295,296				
				NEUTRAL CURRENT CRITERION INSTANTANEOUS VALUES FOR FAULT RECORDING.		297,298				
				DISTURBANCE FREE AND FAST DATA TRANSFER TO & FROM CENTRAL UNIT						
				PHASE SEGRAGATED MEASUREMENT						
				REDUCE CT PERFORMANCE REQUIREMENTS						
				BUILT IN HUMAN MACHINE INTERFACE						
				BUILT IN BREAKER FAILURE FUNCTION.						
B				END FAULT PROTECTION FUNCTION						
				DISTURBANCE RECORDER						
				BINARY OUTPUT : 20						
				BINARY OUTPUT : 6+2-WD						
				FULLY NUMERICAL SIGNAL PROCESSING						
				RATED CURRENT : 1A						
				AUX. VOLTAGE : 60-250V DC						
				RATED FREQUENCY : 60HZ						
C	2	U22.5001	TS-1	TEST SWITCH FOR 87B+50BF-2/BU-D02 RELAY		293	3	MMLG02	ALSTOM	MMLG02 R1AA 0001D
		U22.5002	TS-2	TEST SWITCH FOR 87B+50BF-2/BU-D04 RELAY		295				
		U22.5003	TS-3	TEST SWITCH FOR 87B+50BF-2/BU-D06 RELAY		297				
	3	U26.101	74BF-2/BU-D02	DUAL TARGET RELAY FOR 87B+50BF-2/D02 AND 87B+50BF-2/D04 DC SUPERVISION		232	1	RXSF 1	ABB	RK 271 019-AN
			/74BF-2/BU-D04	AUXILIARY VOLTAGE : 110-125V DC		235				
				CONTACT DATA : 1NO + 2NC						
				FLAG : SELF RESET,REVERSE						
D	4	U26.301	74BF-2/BU-D06	DUAL TARGET RELAY FOR 87B+50BF-2/D06 DC SUPERVISION		238	1	RXSF 1	ABB	RK 271 019-AN
			/SPARE	AUXILIARY VOLTAGE : 110-125V DC						
				CONTACT DATA : 1NO + 2NC						
				FLAG : SELF RESET,REVERSE						
E										
F										


AS-BUILT BY _____ DATE _____		CONTRACT NO. 1113113/00		JOB ORDER NO. S-13656		LIST OF APPARATUS		الشركة الوطنية لنقل الكهرباء National Grid sa	
01	13 49	FACTORY ASBUILT		DRAWN BY RIZ CHECKED BY KVR		132KV BUSBAR PROTN.MAIN-2 BU PANEL +BBP2-5		INDEX PLANT NO. DRAWING NUMBER SHEET NO. REV. NO. - C421 CD-323008 L01 L02 01	
00	13 05	FOR APPROVAL		DATE STARTED 30.01.2013 DATE COMPLETED _____		S/S 8709 - 132/13.8KV IN AL-KHARJ CITY			
REV. NO.	DATE	DESCRIPTION		OPRG. DEPT. CTPD ENG. DEPT. AUT-PSAC		RIYADH SAUDI ARABIA			

NG/D2-D (2012/01)		DMS VECTOR		NGD200	
-------------------	--	------------	--	--------	--

THIS DRAWING AND THE INFORMATION CONTAINED HEREIN ARE THE SOLE PROPERTY OF National Grid sa. NO REPRODUCTION IN FULL OR IN PART SHALL BE OBTAINED FROM THIS DOCUMENT WITHOUT THE WRITTEN CONSENT OF ITS OWNER.

1	2	3	4	5	6	7	8	9	10
---	---	---	---	---	---	---	---	---	----

[illegible]

AS-BUILT BY _____ DATE _____			CONTRACT NO. 11131113/00		JOB ORDER NO. S-13656		LIST OF APPARATUS				<div>نقل الكهرباء</div> <div>الشركة الوطنية لنقل الكهرباء</div> <div>National Grid SA</div>							
DRAWN BY <u>RIZ</u> CHECKED BY <u>KVR</u>			DATE STARTED <u>30.01.2013</u> DATE COMPLETED _____		132KV BUSBAR PROT.N.MAIN-2 BU PANEL +BBP2-5				INDEX		PLANT NO.		DRAWING NUMBER		SHEET NO.		REV. NO.	
01 13 49 FACTORY ASBUILT			DATE STARTED <u>30.01.2013</u> DATE COMPLETED _____		S/S 8709 - 132/13.8KV IN AL-KHARJ CITY				-		C421		CD-323008		SHT. CONT.		01	
00 13 05 FOR APPROVAL			OPRG. DEPT. <u>CTPD</u> ENG. DEPT. <u>AUT-PSAC</u>		RIYADH SAUDI ARABIA										L02 L03			
REV. NO. DATE DESCRIPTION																		

THIS DRAWING AND THE INFORMATION CONTAINED HEREIN ARE THE SOLE PROPERTY OF NATIONAL GRID SA. NO REPRODUCTION IN FULL OR IN PART SHALL BE OBTAINED WITHOUT THE WRITTEN CONSENT OF ITS OWNER.

1 2 3 4 5 6 7 8 9 10

A

B

C

D

E

F

G

LABEL REF.	LABEL ENGRAVING	MATERIALS	ENGRAVING	LABEL SIZE	LETTER SIZE
U0B.5001	U08.5001 87B+50BF-2/BU-D02	TRAFOLITE	BLACK LETTERS ON WHITE BACKGROUND	50X15mm	4mm
U0B.5002	U08.5002 87B+50BF-2/BU-004	TRAFOLITE	BLACK LETTERS ON WHITE BACKGROUND	50X15mm	4mm
U15.5001	U15.5001 87B+50BF-2/BU-006	TRAFOLITE	BLACK LETTERS ON WHITE BACKGROUND	50X15mm	4mm
U22.5001	U22.5001 IS-1	ALUMINUM PAPER FOIL	BLACK LETTERS	50X10mm	3mm
U22.5002	U22.5002 IS-2	ALUMINUM PAPER FOIL	BLACK LETTERS	50X10mm	3mm
U22.5003	U22.5003 IS-3	ALUMINUM PAPER FOIL	BLACK LETTERS	50X10mm	3mm
U26.101	U26.101 74BF-2/D02	ALUMINUM PAPER FOIL	BLACK LETTERS	50X10mm	3mm
U26.301	U26.301 74BF-2/D06	ALUMINUM PAPER FOIL	BLACK LETTERS	50X10mm	3mm
U39.5001	U39.5001 DC SUPPLY MCB FOR D02	TRAFOLITE	BLACK LETTERS ON WHITE BACKGROUND	50X15mm	4mm
U39.5002	U39.5002 DC SUPPLY MCB FOR D04	TRAFOLITE	BLACK LETTERS ON WHITE BACKGROUND	50X15mm	4mm
U39.5003	U39.5003 DC SUPPLY MCB FOR D06	TRAFOLITE	BLACK LETTERS ON WHITE BACKGROUND	50X15mm	4mm
U39.5004	U39.5004 C01-127V,C02-220V	TRAFOLITE	BLACK LETTERS ON WHITE BACKGROUND	50X15mm	4mm
U39.5005	U39.5005 TJ	TRAFOLITE	BLACK LETTERS ON WHITE BACKGROUND	50X15mm	4mm

AS-BUILT BY _____ DATE _____		CONTRACT NO. 11131113/00	JOB ORDER NO. S-13656	LIST OF APPARATUS		الشركة الوطنية لنقل الكهرباء National Grid sa		 نقل الكهرباء National Grid sa	
01	13 49	FACTORY ASBUILT		DRAWN BY RIZ	CHECKED BY KVR	132KV BUSBAR PROTN.MAIN-2 BU PANEL +BBP2-5		INDEX	PLANT NO.
00	13 05	FOR APPROVAL		DATE STARTED 30.01.2013	DATE COMPLETED	S/S 8709 - 132/13.8KV IN AL-KHARJ CITY		DRAWING NUMBER	SHEET NO.
REV. NO.	DATE	DESCRIPTION		OPRG. DEPT. CTPD	ENG. DEPT. AUT-PSAC	RIYADH SAUDI ARABIA		-	C421
								CD-323008	L04/L05
									01

THIS DRAWING AND THE INFORMATION CONTAINED HEREIN ARE THE SOLE PROPERTY OF National Grid sa. NO REPRODUCTION IN FULL OR IN PART SHALL BE OBTAINED FROM THIS DOCUMENT WITHOUT THE WRITTEN CONSENT OF ITS OWNER.

	1	2	3	4	5	6	7	8	9	10
A										
B										
C										
D										
E										
F										
G										

AS-BUILT BY _____ DATE _____		CONTRACT NO. 11131113/00		JOB ORDER NO. S-13656		LIST OF APPARATUS		الشركة الوطنية لنقل الكهرباء National Grid sa	
01	13 49	FACTORY ASBUILT		DRAWN BY RIZ CHECKED BY KVR		132KV BUSBAR PROTN.MAIN-2 BU PANEL +BBP2-5		SHEET NO. SHT CONT.	
00	13 05	FOR APPROVAL		DATE STARTED 30.01.2013 DATE COMPLETED _____		S/S 8709 - 132/13.8KV IN AL-KHARJ CITY		REV. NO. 01	
REV. NO.	DATE	DESCRIPTION		OPRG. DEPT. CTPD ENG. DEPT. AUT-PSAC		RIYADH SAUDI ARABIA		INDEX PLANT NO. DRAWING NUMBER SHEET NO. REV. NO.	
						- C421 CD-323008		L05 NIL	

NG/D2-D (2012/01)
DMS VECTOR NGD200

THIS DRAWING AND THE INFORMATION CONTAINED HEREIN ARE THE SOLE PROPERTY OF National Grid sa NO REPRODUCTION IN FULL OR IN PART SHALL BE OBTAINED FROM THIS DOCUMENT WITHOUT THE WRITTEN CONSENT OF ITS OWNER.



POWER SYSTEMS NETWORK MANAGEMENT
PROTECTION AND SUBSTATION AUTOMATION SYSTEMS
WBS NO: S-13656

ABB AUTOMATION COMPANY LTD.
414, AL-KHARJ ROAD
SECOND INDUSTRIAL CITY
RIYADH-11383 K.S.A

CONTRACTOR : ABB Contracting Company
CLIENT : National Gridsa
PROJECT : CONSTRUCTION OF NEW 132/13.8kV SS 8709 IN AL-KHARJ CITY
SUBSTATION : S/S 8709
CONTRACT NO. : 11131113/00
TITLE : SCHEMATICS DRAWINGS - +BBP2-5
[132KV BUSBAR PROTECTION MAIN-2 BAY UNIT PANEL]

AS-BUILT BY _____ DATE _____ CONTRACT NO. 11131113/00 JOB ORDER NO. S-13656

01	13 49	FACTORY ASBUILT	DRAWN BY RIZ	CHECKED BY KVR
00	13 05	FOR APPROVAL	DATE STARTED 30.01.2013	DATE COMPLETED
REV. NO.	DATE	DESCRIPTION	OPRG. DEPT. CTPD	ENG. DEPT. AUT-PSAC

COVER SHEET

132KV BUSBAR PROTN.MAIN-2 BU PANEL +BBP2-5
S/S 8709 - 132/13.8KV IN AL-KHARJ CITY
RIYADH SAUDI ARABIA

الشركة الوطنية لنقل الكهرباء



نقل الكهرباء
National Grid sa

INDEX	PLANT NO.	DRAWING NUMBER	SHEET NO.	REV. NO.
-	C421	CD-323009	SHT CONT. 000 001	01

NG/D2-D (2012/01)

DMS

VECTOR

NGD200

1

2

3

4

5

6

7

8

9

10

A

CONTENTS	ABB SHT.NO.	REV.00	REV.01	REV.02
COVER SHEET	000	X	X	
CONTENTS SHEET	001	X	X	
GRAPHICAL SYMBOLS FOR DIAGRAMS	011	X	X	
GRAPHICAL SYMBOLS FOR DIAGRAMS	012	X	X	
COMMON LEGEND	013	X	X	
FERRULE AND WIRING DETAILS	014	X	X	
DRAWING REFERENCES	015	X	X	
DRAWING REFERENCES	016	X	X	
PRIMARY SYSTEM	051-056	X	X	
AC SUPPLY FOR ILLUMINATION & POWER SOCKET	211	X	X	
CUB. LIGHTING, HEATER & SOCKET ALARM CKT.	212	X	X	
DC SUPPLY DISTRIBUTION	216	X	X	
CURRENT TRANSFORMER INPUTS -87B+50BF-2/BU-D02	221	X	X	
CURRENT TRANSFORMER INPUTS -87B+50BF-2/BU-D04	222	X	X	
CURRENT TRANSFORMER INPUTS -87B+50BF-2/BU-D06	223	X	X	
87B+50BF-2/BU-D02 PROTN.RELAY-BINARY INPUTS	231	X	X	
87B+50BF-2/BU-D02 PROTN.RELAY-BINARY INPUTS	232	X	X	
CBF + BUSBAR PROTN.-2 TRIP RELAY CIRCUIT -D05	233	X	X	
87B+50BF-2/BU-D04 PROTN.RELAY-BINARY INPUTS	234	X	X	
87B+50BF-2/BU-D04 PROTN.RELAY-BINARY INPUTS	235	X	X	
CBF + BUSBAR PROTN.-2 TRIP RELAY CIRCUIT -D03	236	X	X	
87B+50BF-2/BU-D06 PROTN.RELAY-BINARY INPUTS	237	X	X	
87B+50BF-2/BU-D06 PROTN.RELAY-BINARY INPUTS	238	X	X	
CBF + BUSBAR PROTN.-2 TRIP RELAY CIRCUIT -D01	239	X	X	

B

C

D

E

F

CONTENTS	ABB SHT.NO.	REV.00	REV.01	REV.02
COMMON ALARM CIRCUITS	292	X	X	
BLOCK REFERENCE 87B+50BF-2/BU-D02	293	X	X	
BLOCK REFERENCE 87B+50BF-2/BU-D02	294	X	X	
BLOCK REFERENCE 87B+50BF-2/BU-D04	295	X	X	
BLOCK REFERENCE 87B+50BF-2/BU-D04	296	X	X	
BLOCK REFERENCE 87B+50BF-2/BU-D06	297	X	X	
BLOCK REFERENCE 87B+50BF-2/BU-D06	298	X	X	
TERMINAL BLOCKS REFERENCE	301	X	X	

AS-BUILT BY _____ DATE _____		CONTRACT NO. 1113113/00		JOB ORDER NO. S-13656		CONTENTS SHEET		نقل الكهرباء الشركة الوطنية لنقل الكهرباء National Grid sa	
01	13 49	FACTORY ASBUILT		DRAWN BY RIZ CHECKED BY KVR		32KV BUSBAR PROTN.MAIN-2 BU PANEL +BBP2-5		INDEX PLANT NO. DRAWING NUMBER SHEET NO. REV. NO. 001 13 05 1002 01	
00	13 05	FOR APPROVAL		DATE STARTED 30.01.2013 DATE COMPLETED _____		S/S 8709 - 132/13.8KV IN AL-KHARJ CITY		NG/D2-D (2012/01) NGD200	
REV. NO.	DATE	DESCRIPTION		OPRG. DEPT. CTPD ENG. DEPT. AUT-PSAC		RIYADH SAUDI ARABIA		DMS VECTOR	

THIS DRAWING AND THE INFORMATION CONTAINED HEREIN ARE THE SOLE PROPERTY OF National Grid sa. NO REPRODUCTION IN FULL OR IN PART SHALL BE OBTAINED FROM THIS DOCUMENT WITHOUT THE WRITTEN CONSENT OF ITS OWNER.

	1	2	3	4	5	6	7	8	9	10																																																																																																																		
A																																																																																																																												
B																																																																																																																												
C																																																																																																																												
D																																																																																																																												
E																																																																																																																												
F																																																																																																																												
	<table><tr><th>SYMBOL</th><th>DESCRIPTION</th><th>SYMBOL</th><th>DESCRIPTION</th><th>SYMBOL</th><th>DESCRIPTION</th></tr><tr><td></td><td>FRAME CONNECTION</td><td></td><td>MAIN CONTACT OF A CIRCUIT BREAKER</td><td></td><td>RELAY WITH TWO MAKE CONTACTS, ONE OF THEM DELAYED WHEN OPERATING</td></tr><tr><td></td><td>EARTH CONNECTION</td><td></td><td>PASSING MAKE CONTACT CLOSING MOMENTARILY DURING OPERATION AND RELEASE</td><td></td><td>RELAY WITH TWO ACTUATORS AND A TWO STABLE POSITIONS</td></tr><tr><td></td><td>RESISTOR</td><td></td><td>BREAK CONTACT DELAYED WHEN OPERATING</td><td></td><td></td></tr><tr><td></td><td>VARIABLE RESISTOR</td><td></td><td>MAKE CONTACT DELAYED WHEN RELEASING</td><td></td><td>SIGNALLING LAMP</td></tr><tr><td></td><td>RESISTOR WITH PRESET ADJUSTMENT</td><td></td><td>TWO MECHANICAL LINKS CROSSING WITHOUT CONNECTION</td><td></td><td>MECHANICAL INDICATOR WITH AUTOMATIC RESET</td></tr><tr><td></td><td>CAPACITOR</td><td></td><td>JUNCTION OF MECHANICAL LINKS</td><td></td><td>MECHANICAL INDICATOR WITH NON-AUTOMATIC RESET</td></tr><tr><td></td><td>SEMICONDUCTOR DIODE USED AS A CAPACITIVE DEVICE</td><td></td><td>AUTOMATIC RESET</td><td></td><td>ELECTRICALLY CONTROLLED MECHANICAL INDICATOR WITH AUTOMATIC RESET</td></tr><tr><td></td><td>OPEN CONTACT, MAKE CONTACT</td><td></td><td>NON-AUTOMATIC RESET</td><td></td><td>ELECTRICALLY CONTROLLED MECHANICAL INDICATOR WITH NON-AUTOMATIC RESET</td></tr><tr><td></td><td>CLOSED CONTACT, BREAK CONTACT</td><td></td><td>SWITCHING DEVICE WITH MANUAL OPERATION AND WITH AUTOMATIC RESET</td><td></td><td>RELAY WITH MECHANICAL INDICATOR</td></tr><tr><td></td><td>CHANGE-OVER CONTACT, BREAK BEFORE MAKE</td><td></td><td>SWITCHING DEVICE WITH MANUAL OPERATION AND WITH NON-AUTOMATIC RESET</td><td></td><td>ELECTRO-MECHANICAL POSITION INDICATOR WITH ONE DE-ENERGIZED AND ONE OPERATED POSITION</td></tr><tr><td></td><td>MAKE CONTACT WHICH IS EARLY WHEN OPERATING AND LATE WHEN RELEASING</td><td></td><td>CHANGE-OVER SWITCHING DEVICE WITH MANUAL CONTROL</td><td></td><td>ELECTRO-MECHANICAL POSITION INDICATOR WITH ONE DE-ENERGIZED AND TWO OPERATED POSITIONS</td></tr><tr><td></td><td>BREAK CONTACT WHICH IS LATE WHEN OPERATING AND EARLY WHEN RELEASING</td><td></td><td>RELAY WITH MAKE CONTACT</td><td></td><td>BELL, BUZZER</td></tr><tr><td></td><td>SWITCHING DEVICE WITH MANUAL CONTROL</td><td></td><td>RELAY WITH CHANGE-OVER CONTACT</td><td></td><td>SIREN , HORN</td></tr><tr><td></td><td>MAKE CONTACT DELAYED WHEN OPERATING</td><td></td><td>RELAY WITH MAKE CONTACT, DELAYED WHEN OPERATING</td><td></td><td></td></tr><tr><td></td><td>BREAK CONTACT DELAYED WHEN RELEASING</td><td></td><td>RELAY WITH MAKE CONTACT, DELAYED WHEN RELEASING</td><td></td><td></td></tr><tr><td></td><td>MAKE CONTACT DELAYED WHEN OPERATING AND RELEASING</td><td></td><td>RELAY WITH MAKE CONTACT, DELAYED WHEN OPERATING AND RELEASING</td><td></td><td></td></tr><tr><td></td><td>MAIN CONTACT OF A SWITCH DISCONNECTOR</td><td></td><td></td><td></td><td></td></tr><tr><td></td><td>MAIN CONTACT OF A DISCONNECTOR</td><td></td><td></td><td></td><td></td></tr></table>										SYMBOL	DESCRIPTION	SYMBOL	DESCRIPTION	SYMBOL	DESCRIPTION		FRAME CONNECTION		MAIN CONTACT OF A CIRCUIT BREAKER		RELAY WITH TWO MAKE CONTACTS, ONE OF THEM DELAYED WHEN OPERATING		EARTH CONNECTION		PASSING MAKE CONTACT CLOSING MOMENTARILY DURING OPERATION AND RELEASE		RELAY WITH TWO ACTUATORS AND A TWO STABLE POSITIONS		RESISTOR		BREAK CONTACT DELAYED WHEN OPERATING				VARIABLE RESISTOR		MAKE CONTACT DELAYED WHEN RELEASING		SIGNALLING LAMP		RESISTOR WITH PRESET ADJUSTMENT		TWO MECHANICAL LINKS CROSSING WITHOUT CONNECTION		MECHANICAL INDICATOR WITH AUTOMATIC RESET		CAPACITOR		JUNCTION OF MECHANICAL LINKS		MECHANICAL INDICATOR WITH NON-AUTOMATIC RESET		SEMICONDUCTOR DIODE USED AS A CAPACITIVE DEVICE		AUTOMATIC RESET		ELECTRICALLY CONTROLLED MECHANICAL INDICATOR WITH AUTOMATIC RESET		OPEN CONTACT, MAKE CONTACT		NON-AUTOMATIC RESET		ELECTRICALLY CONTROLLED MECHANICAL INDICATOR WITH NON-AUTOMATIC RESET		CLOSED CONTACT, BREAK CONTACT		SWITCHING DEVICE WITH MANUAL OPERATION AND WITH AUTOMATIC RESET		RELAY WITH MECHANICAL INDICATOR		CHANGE-OVER CONTACT, BREAK BEFORE MAKE		SWITCHING DEVICE WITH MANUAL OPERATION AND WITH NON-AUTOMATIC RESET		ELECTRO-MECHANICAL POSITION INDICATOR WITH ONE DE-ENERGIZED AND ONE OPERATED POSITION		MAKE CONTACT WHICH IS EARLY WHEN OPERATING AND LATE WHEN RELEASING		CHANGE-OVER SWITCHING DEVICE WITH MANUAL CONTROL		ELECTRO-MECHANICAL POSITION INDICATOR WITH ONE DE-ENERGIZED AND TWO OPERATED POSITIONS		BREAK CONTACT WHICH IS LATE WHEN OPERATING AND EARLY WHEN RELEASING		RELAY WITH MAKE CONTACT		BELL, BUZZER		SWITCHING DEVICE WITH MANUAL CONTROL		RELAY WITH CHANGE-OVER CONTACT		SIREN , HORN		MAKE CONTACT DELAYED WHEN OPERATING		RELAY WITH MAKE CONTACT, DELAYED WHEN OPERATING				BREAK CONTACT DELAYED WHEN RELEASING		RELAY WITH MAKE CONTACT, DELAYED WHEN RELEASING				MAKE CONTACT DELAYED WHEN OPERATING AND RELEASING		RELAY WITH MAKE CONTACT, DELAYED WHEN OPERATING AND RELEASING				MAIN CONTACT OF A SWITCH DISCONNECTOR						MAIN CONTACT OF A DISCONNECTOR				
SYMBOL	DESCRIPTION	SYMBOL	DESCRIPTION	SYMBOL	DESCRIPTION																																																																																																																							
	FRAME CONNECTION		MAIN CONTACT OF A CIRCUIT BREAKER		RELAY WITH TWO MAKE CONTACTS, ONE OF THEM DELAYED WHEN OPERATING																																																																																																																							
	EARTH CONNECTION		PASSING MAKE CONTACT CLOSING MOMENTARILY DURING OPERATION AND RELEASE		RELAY WITH TWO ACTUATORS AND A TWO STABLE POSITIONS																																																																																																																							
	RESISTOR		BREAK CONTACT DELAYED WHEN OPERATING																																																																																																																									
	VARIABLE RESISTOR		MAKE CONTACT DELAYED WHEN RELEASING		SIGNALLING LAMP																																																																																																																							
	RESISTOR WITH PRESET ADJUSTMENT		TWO MECHANICAL LINKS CROSSING WITHOUT CONNECTION		MECHANICAL INDICATOR WITH AUTOMATIC RESET																																																																																																																							
	CAPACITOR		JUNCTION OF MECHANICAL LINKS		MECHANICAL INDICATOR WITH NON-AUTOMATIC RESET																																																																																																																							
	SEMICONDUCTOR DIODE USED AS A CAPACITIVE DEVICE		AUTOMATIC RESET		ELECTRICALLY CONTROLLED MECHANICAL INDICATOR WITH AUTOMATIC RESET																																																																																																																							
	OPEN CONTACT, MAKE CONTACT		NON-AUTOMATIC RESET		ELECTRICALLY CONTROLLED MECHANICAL INDICATOR WITH NON-AUTOMATIC RESET																																																																																																																							
	CLOSED CONTACT, BREAK CONTACT		SWITCHING DEVICE WITH MANUAL OPERATION AND WITH AUTOMATIC RESET		RELAY WITH MECHANICAL INDICATOR																																																																																																																							
	CHANGE-OVER CONTACT, BREAK BEFORE MAKE		SWITCHING DEVICE WITH MANUAL OPERATION AND WITH NON-AUTOMATIC RESET		ELECTRO-MECHANICAL POSITION INDICATOR WITH ONE DE-ENERGIZED AND ONE OPERATED POSITION																																																																																																																							
	MAKE CONTACT WHICH IS EARLY WHEN OPERATING AND LATE WHEN RELEASING		CHANGE-OVER SWITCHING DEVICE WITH MANUAL CONTROL		ELECTRO-MECHANICAL POSITION INDICATOR WITH ONE DE-ENERGIZED AND TWO OPERATED POSITIONS																																																																																																																							
	BREAK CONTACT WHICH IS LATE WHEN OPERATING AND EARLY WHEN RELEASING		RELAY WITH MAKE CONTACT		BELL, BUZZER																																																																																																																							
	SWITCHING DEVICE WITH MANUAL CONTROL		RELAY WITH CHANGE-OVER CONTACT		SIREN , HORN																																																																																																																							
	MAKE CONTACT DELAYED WHEN OPERATING		RELAY WITH MAKE CONTACT, DELAYED WHEN OPERATING																																																																																																																									
	BREAK CONTACT DELAYED WHEN RELEASING		RELAY WITH MAKE CONTACT, DELAYED WHEN RELEASING																																																																																																																									
	MAKE CONTACT DELAYED WHEN OPERATING AND RELEASING		RELAY WITH MAKE CONTACT, DELAYED WHEN OPERATING AND RELEASING																																																																																																																									
	MAIN CONTACT OF A SWITCH DISCONNECTOR																																																																																																																											
	MAIN CONTACT OF A DISCONNECTOR																																																																																																																											

AS-BUILT BY	DATE	CONTRACT NO.	11131113/00	JOB ORDER NO.	S-13656	GRAPHICAL SYMBOLS FOR DIAGRAMS		الشركة الوطنية لنقل الكهرباء		نقل الكهرباء	
01	13 49	FACTORY ASBUILT	DRAWN BY	RIZ	CHECKED BY	KVR	32KV BUSBAR PROTN.MAIN-2 BU PANEL +BBP2-5	National Grid sa			
00	13 05	FOR APPROVAL	DATE STARTED	30.01.2013	DATE COMPLETED		S/S 8709 - 132/13.8KV IN AL-KHARJ CITY	INDEX		PLANT NO.	DRAWING NUMBER
REV. NO.	DATE	DESCRIPTION	OPRG. DEPT.	CTPD	ENG. DEPT.	AUT-PSAC	RIYADH	-		C421	CD-323009
							SAUDI ARABIA		SHEET NO.		REV. NO.
									SHT		CDT
									011		012
									01		
									NG/D2-0 (2012/01)		
									DMS		VECTOR
									NGD200		

THIS DRAWING AND THE INFORMATION CONTAINED HEREIN ARE THE SOLE PROPERTY OF National Grid sa. NO REPRODUCTION IN FULL OR IN PART SHALL BE OBTAINED FROM THIS DOCUMENT WITHOUT THE WRITTEN CONSENT OF ITS OWNER.

	1	2	3	4	5	6	7	8	9	10
A										
B										
C										
D										
E										
F										

SYMBOL	DESCRIPTION	SYMBOL	DESCRIPTION	SYMBOL	DESCRIPTION
	FUSE / LINK		WATTMETER		ELEMENT WITH NEGATED INHIBITING INPUT
	FUSE WITH THE SUPPLY SIDE INDICATED		VARMETER		ELEMENT WITH INPUT WHICH DOES NOT CARRY ANY LOGIC INFORMATION
	SINGLE-PHASE TRANSFORMER WITH TWO SEPARATE WINDINGS (TWO ALTERNATIVE FORMS)		POWER FACTOR METER		ELEMENT WITH POSTPONED OUTPUT
	SINGLE-PHASE TRANSFORMER WITH TWO SEPARATE WINDINGS (TWO ALTERNATIVE FORMS)		POSITION INDICATOR		AND-ELEMENT WITH TWO INPUTS
	SINGLE-PHASE TRANSFORMER WITH FERRO MAGNETIC CORE		SYNCHROSCOPE		OR-ELEMENT WITH TWO INPUTS
	SINGLE-PHASE VOLTAGE TRANSFORMER (MULTI-LINE AND SINGLE-LINE REPRESENTATION)		RECORDING VOLTMETER		LOGIC THRESHOLD ELEMENT WITH FOUR INPUTS AND THRESHOLD VALUE 2
	SINGLE-PHASE VOLTAGE TRANSFORMER WITH TWO SECONDARY WINDINGS (MULTI-LINE AND SINGLE-LINE REPRESENTATION)		RECORDING WATTMETER		ELEMENT WITH THREE INPUTS FOR "2 AND ONLY 2"
	CURRENT TRANSFORMER (MULTI-LINE AND SINGLE-LINE REPRESENTATION)		HOUR METER		EXCLUSIVE OR-ELEMENT WITH THREE INPUTS
	CURRENT TRANSFORMER WITH TWO CORES (MULTI-LINE AND SINGLE-LINE REPRESENTATION)		WATT-HOUR METER		LOGIC IDENTITY ELEMENT WITH THREE INPUTS
	CURRENT TRANSFORMER WITH TWO SECONDARY WINDINGS ON ONE CORE (MULTI-LINE AND SINGLE-LINE REPRESENTATION)		WATT-HOUR METER FOR ENERGY FROM A BUSBAR SYSTEM		MAJORITY ELEMENT WITH THREE INPUTS
	FILTER		ELEMENT WITH STATIC INPUT		NEGATOR
	HIGH-PASS FILTER		ELEMENT WITH STATIC NEGATED INPUT		NAND ELEMENT WITH TWO INPUTS
	BAND-PASS FILTER		ELEMENT WITH STATIC NEGATED OUTPUT		NOR ELEMENT WITH TWO INPUTS
	VOLTMETER		ELEMENT WITH DYNAMIC INPUT		BISTABLE ELEMENT
	AMMETER		ELEMENT WITH DYNAMIC NEGATED INPUT		
			ELEMENT WITH INHIBITING INPUT		

AS-BUILT BY _____	DATE _____	CONTRACT NO. 1113113/00	JOB ORDER NO. S-13656	GRAPHICAL SYMBOLS FOR DIAGRAMS		نقل الكهرباء الشركة الوطنية لنقل الكهرباء National Grid sa				
01 13 49	FACTORY ASBUILT	DRAWN BY RIZ	CHECKED BY KVR	132KV BUSBAR PROTN.MAIN-2 BU PANEL +BPP2-5		INDEX	PLANT NO.	DRAWING NUMBER	SHEET NO.	REV. NO.
00 13 05	FOR APPROVAL	DATE STARTED 30.01.2013	DATE COMPLETED _____	S/S 8709 - 132/13.8KV IN AL-KHARJ CITY		-	C421	CD-323009	SHT CONT	01
REV. NO.	DATE	DESCRIPTION	OPRG. DEPT. CTPD	ENG. DEPT. AUT-PSAC	RIYADH SAUDI ARABIA				012 013	

NG/D2-D (2012/01)
DMS VECTOR NGD200

	1	2	3	4	5	6	7	8	9	10
A										
B										
C										
D										
E										
F										

LEGENDS

±R1	DC SUPPLY - MAIN PROTECTION
±R2	DC SUPPLY - SECONDARY PROTECTION
±R3	DC SUPPLY - BACK UP PROTECTION
±IT	DC SUPPLY - INTER TRIP
FL	DC SUPPLY - FLASHING CIRCUIT
BB RS±	DC SUPPLY - BUS BAR - PROTECTION RESET
BB CBF±/CBF±	DC SUPPLY - CBF PROTECTION
R	RESET BUS - ALARM SYSTEM
CR	CONTROL ROOM
ECC	ENERGY CONTROL CENTRE
LOCAL	THE LOCATION OF CONTROLLED DEVICE
REMOTE	ANY OTHER LOCATION NOT LOCAL
ON	CB NORMALLY OPEN AUXILIARY CONTACT
OFF	CB NORMALLY CLOSED AUXILIARY CONTACT
A	COMMON
T	TEST POSITION
S	SERVICE POSITION
CS	CLOSE IN SERVICE POSITION
CT	CLOSE IN TEST POSITION
LS	LOCAL SERVICE
LT	LOCAL TEST
LC	LOCAL CLOSE
LO	LOCAL OPEN
RO	REMOTE OPEN
OP	OPERATE
RE	RESET

NOTES

LABELS

WHITE LABEL WITH BLACK LETTERING WILL BE PROVIDED FOR ALL MOUNTED APPARATUS EQUIPMENT IDENTIFICATION AND FUNCTION REFERENCE LABEL WILL BE PROVIDED FOR FRONT MOUNTED EQUIPMENTS OF THE PANEL AND EQUIPMENT IDENTIFICATION LABEL WILL BE PROVIDED FOR INTERNALLY MOUNTED EQUIPMENTS

WIRING

PVC INSULATED 600V GRADE
 2.5 SQ.mm. YELLOW COLOURED FOR CT CIRCUITS
 2.5 SQ.mm. RE COLOURED FOR VT CIRCUITS
 1.5 SQ.mm. GREY COLOURED FOR DC SUPPLY, SCADA AND CONTROL CIRCUITS
 2.5 SQ.mm. BLACK COLOURED FOR AVC AND AC CIRCUITS
 2.5 SQ.mm. YELLOW/GREEN COLOURED FOR EARTHING CONNECTIONS
 FOLLOWING MARKERS SHALL BE PROVIDED ON FOLLOWING WIRES:
 + SIGN FOR DC + WIRE
 - SIGN FOR DC - WIRE


LUGS

A. CT CIRCUITS- RING TYPE
 B. OTHER CIRCUITS - SPADE TYPE

FERULLING

YELLOW TUBE 3.2 mm FOR 1.5SQ mm WIRES AND 4.2 FOR 2.5 SQ mm WIRES (AS PER 31 - TMSS-1, RE.0)

AS-BUILT BY _____ DATE _____			CONTRACT NO. 1113113/00		JOB ORDER NO. S-13656		COMMON LEGEND				الشركة الوطنية لنقل الكهرباء National Grid sa									
G	01	13 49	FACTORY ASBUILT		DRAWN BY RIZ		CHECKED BY KVR		132KV BUSBAR PROTN.MAIN-2 BU PANEL +BBP2-5				INDEX	PLANT NO.	DRAWING NUMBER		SHEET NO.		REV. NO.	
	00	13 05	FOR APPROVAL		DATE STARTED 30.01.2013		DATE COMPLETED		S/S 8709 - 132/13.8KV IN AL-KHARJ CITY				-	C421	CD-323009		SHT CONT.		01	
	REV. NO.	DATE	DESCRIPTION		OPRG. DEPT. CTPD		ENG. DEPT. AUT-PSAC		RIYADH SAUDI ARABIA											
																			NG/D2-D (2012/01)	
																			DMS VECTOR NGD200	

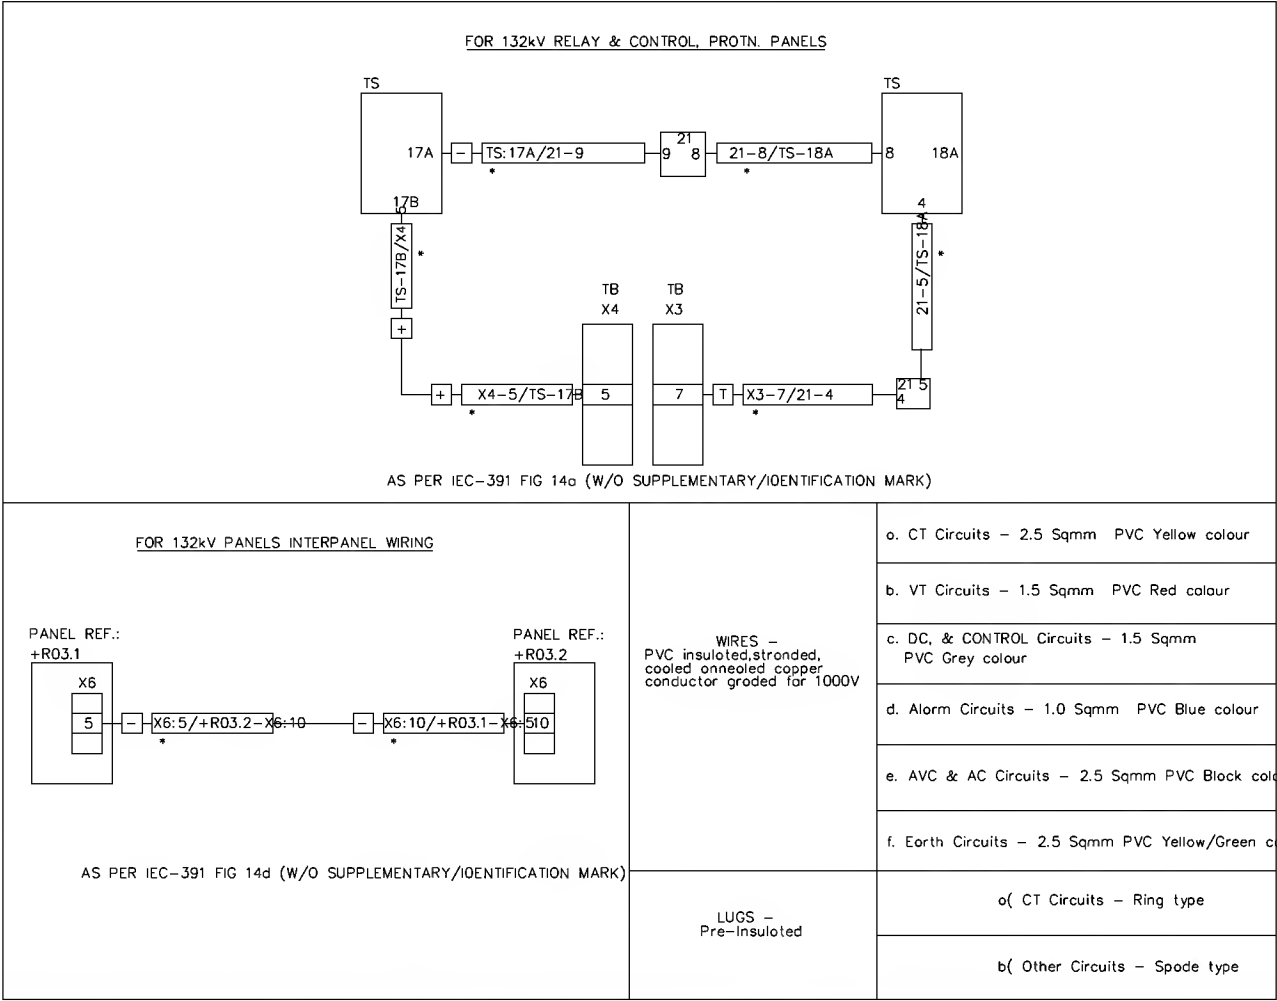

NOTE:1 ADDITIONAL MARKING AS APPLICABLE

NOTE:2 FERRULE NUMBERING WILL BE BLACK LETTERS ON YELLOW TUBE

3.2 mm for 1.5 sq mm wires and

4.2 mm for 2.5 sq mm wires

(As per 31-TMSS-1, REV 0)

NOTE:3 STARTING POINT OF THE FERRULE LEFT TO RIGHT

AS-BUILT BY _____ DATE _____ CONTRACT NO. 1113113/00 JOB ORDER NO. S-13656

01	13 49	FACTORY ASBUILT
00	13 05	FOR APPROVAL
REV. NO.	DATE	DESCRIPTION

DRAWN BY RIZ CHECKED BY KVR

DATE STARTED 30.01.2013 DATE COMPLETED _____

OPRG. DEPT. CTPD ENG. DEPT. AUT-PSAC

FERRULE AND WIRING DETAILS

132KV BUSBAR PROTN.MAIN-2 BU PANEL +BBP2-5

S/S 8709 - 132/13.8KV IN AL-KHARJ CITY

RIYADH SAUDI ARABIA

الشركة الوطنية لنقل الكهرباء



INDEX	PLANT NO.	DRAWING NUMBER	SHEET NO.	REV. NO.
-	C421	CD-323009	014	01

NG/02-0 (2012/01)

DMS

VECTOR

NG0200

	1	2	3	4	5	6	7	8	9	10
A										
B										
C										
D										
E										
F										
G										

ABB

PROTECTION & SUBSTATION
AUTOMATION

MANUFACTURER	SCHEMATICS DWG.NO	PANEL DESCRIPTION	PANEL REFERENCE
		SS 8709 13.8KV RELAY PANELS	
	CD-322952	13.8KV Capacitor Bank-1 Protection Panel	+C8P-1
	CD-322954	13.8KV Capacitor Bank-2 Protection Panel	+C8P-2
	CD-322956	13.8KV Capacitor Bank-2 Protection Panel	+CBP-3
	CD-322958	13.8 KV ACCS PANEL	+ACCS
	CD-322962	13.8KV ACSE PANEL	+ACSE
	CD-322968	13.8KV Under Voltage Load Shedding Panel	+UVLS
	CD-322964	13.8KV Under Frequency Load Shedding Panel-1	+UFLS01
	CD-322966	13.8KV Under Frequency Load Shedding Panel-2	+UFLS02


AS-BUILT by _____ DATE _____		CONTRACT NO. 11131113/00	JOB ORDER NO. S-13656	DRAWING REFERENCES		الشركة الوطنية لنقل الكهرباء National Grid sa				
01	13 49	FACTORY ASBUILT		132KV BUSBAR PROTN.MAIN-2 BU PANEL +BBP2-5		INDEX	PLANT NO.	DRAWING NUMBER	SHEET NO.	REV. NO.
00	13 05	FOR APPROVAL		S/S 8709 - 132/13.8KV IN AL-KHARJ CITY					SHT CONT	
REV. NO.	DATE	DESCRIPTION	OPRG. DEPT. CTPD	ENG. DEPT. AUT-PSAC	RIYADH	SAUDI ARABIA	-	C421	CD-323009	016 051 01

NG/D2-D (2012/01)
DMS VECTOR NGD200




CT	RATIO	CLASS	VK IN VOLTS	IMAG @ VK IN mA	RCT IN (OHMS)	BURDEN IN VA	FUNCTION
CT1-1	1600-1200-800/1A	X	>1400	≤100	≤2	-	MAIN-1(IED-1)
CT1-2	1600-1200-800/1A	X	>1400	≤100	≤2	-	MAIN-2(IED-2)
CT1-3	1600-1200-800/1A	X	>1400	≤100	≤2	-	METERING
CT1-4	1600-1200-800/1A	X	>1400	≤100	≤2	-	SPARE
CT1-5	2000/1A	X	>600	≤25	≤5	-	87B MAIN-1
CT1-6	2000/1A	X	>600	≤25	≤5	-	87B MAIN-2

AS-BUILT BY _____ DATE _____		CONTRACT NO. 1113113/00		JOB ORDER NO. S-13656		PRIMARY SYSTEM (8020 UGF BAY-D02)		نقل الكهرباء الشركة الوطنية لنقل الكهرباء National Grid sa	
DRAWN BY RIZ CHECKED BY KVR		DATE STARTED 30.01.2013 DATE COMPLETED _____		32KV BUSBAR PROTN.MAIN-2 BU PANEL +BBP2-5		S/S 8709 - 132/13.8KV IN AL-KHARJ CITY			
FOR APPROVAL		PRG. DEPT. CTPD ENG. DEPT. AUT-PSAC		RIYADH SAUDI ARABIA		INDEX PLANT NO. C421		DRAWING NUMBER CD-323009	
REV. NO.	DATE	DESCRIPTION		SHEET NO. 051		SHEET CONT. 052		REV. NO. 01	

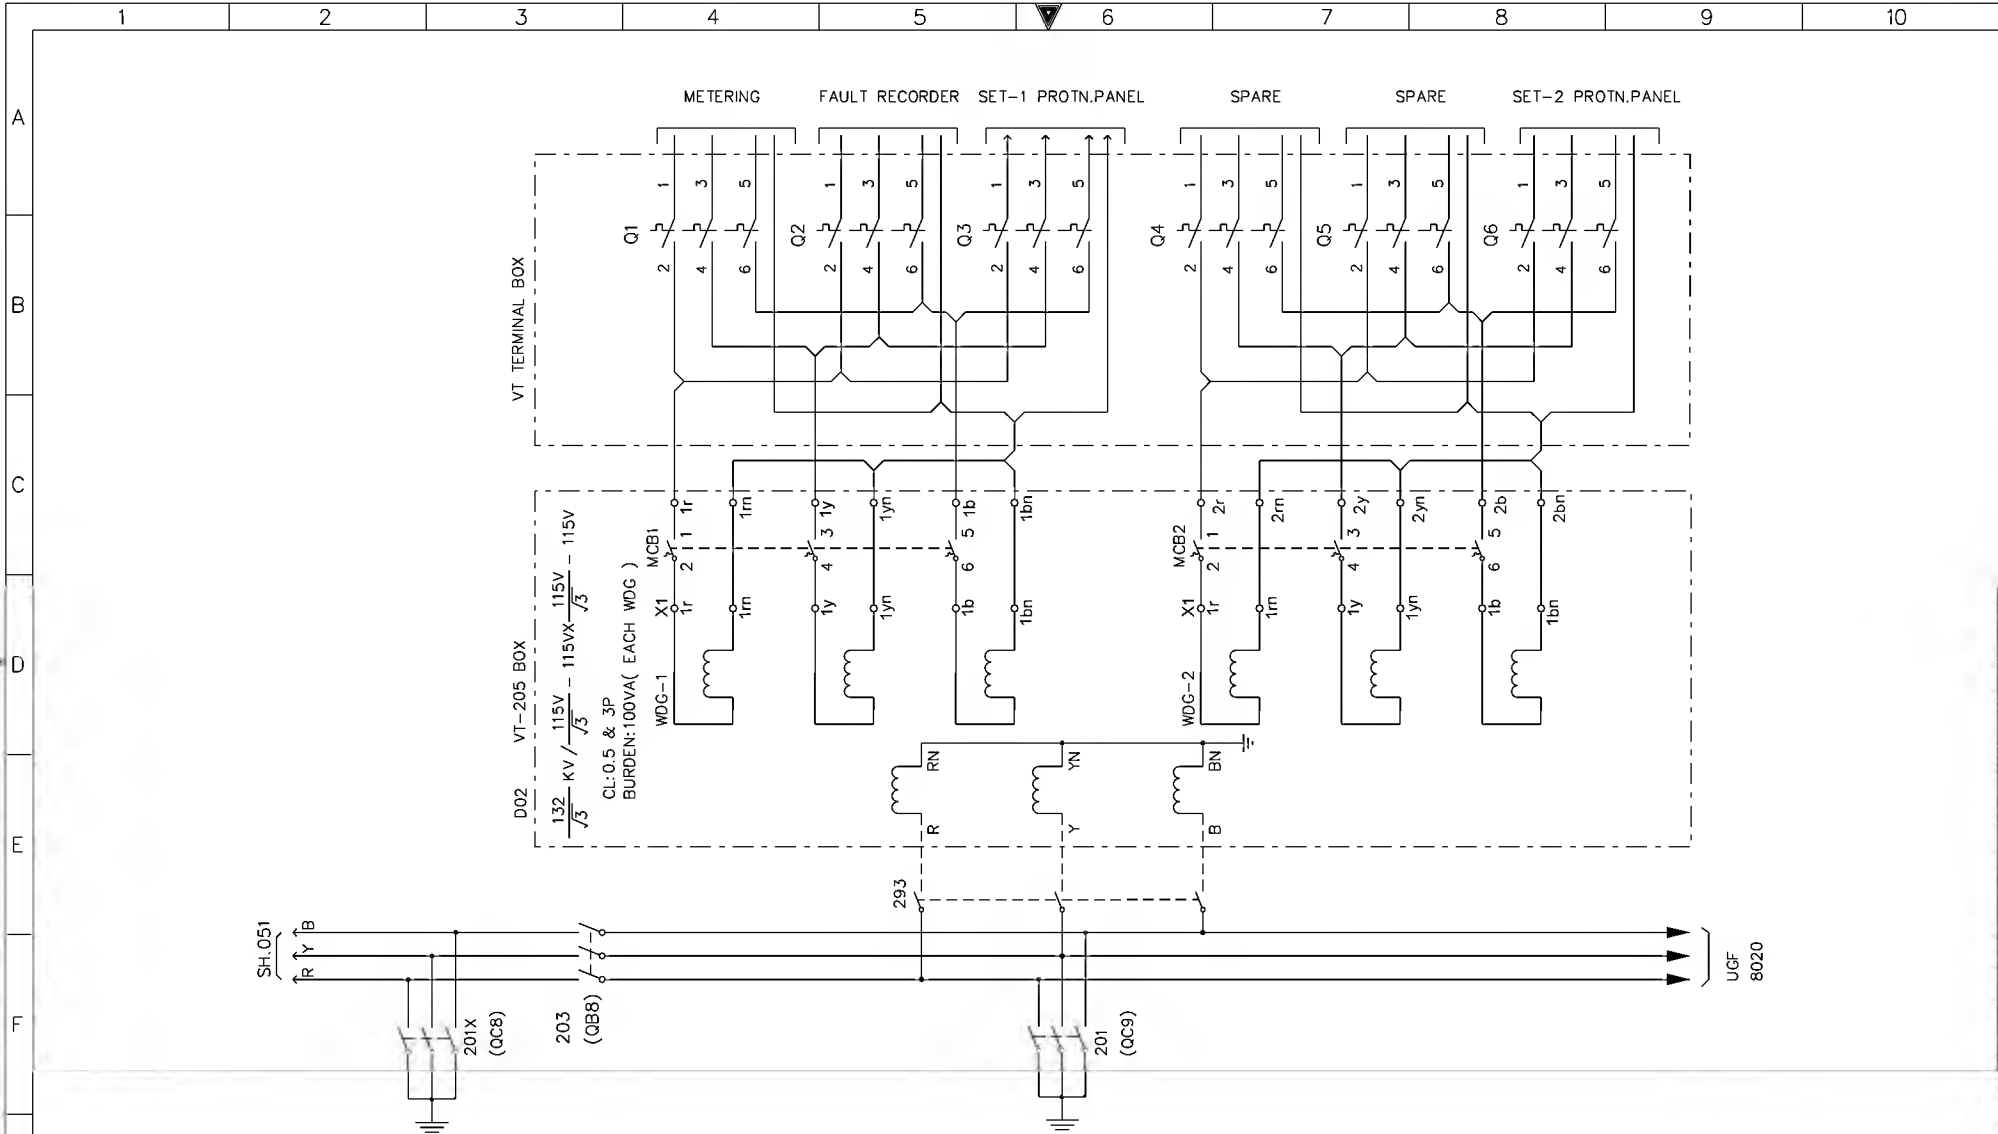


AS-BUILT BY _____ DATE _____			CONTRACT NO. 11131113/00		JOB ORDER NO. S-13656		PRIMARY SYSTEM (8020 UGF BAY-D02)			الشركة الوطنية لنقل الكهرباء		
DRAWN BY RIZ CHECKED BY KVR			DATE STARTED 30.01.2013 DATE COMPLETED _____		132KV BUSBAR PROTN.MAIN-2 BU PANEL +BBP2-5		National Grid SA			نقل الكهرباء		
01 13 49 FACTORY ASBUILT			OPRG. DEPT. CTFD ENG. DEPT. AUT-PSAC		S/S 8709 - 132/13.8KV IN AL-KHARJ CITY		INDEX PLANT NO. DRAWING NUMBER			SHEET NO. REV. NO.		
00 13 05 FOR APPROVAL					RIYADH SAUDI ARABIA		- C421 CD-323009			052/053 01		
REV. NO. DATE DESCRIPTION												

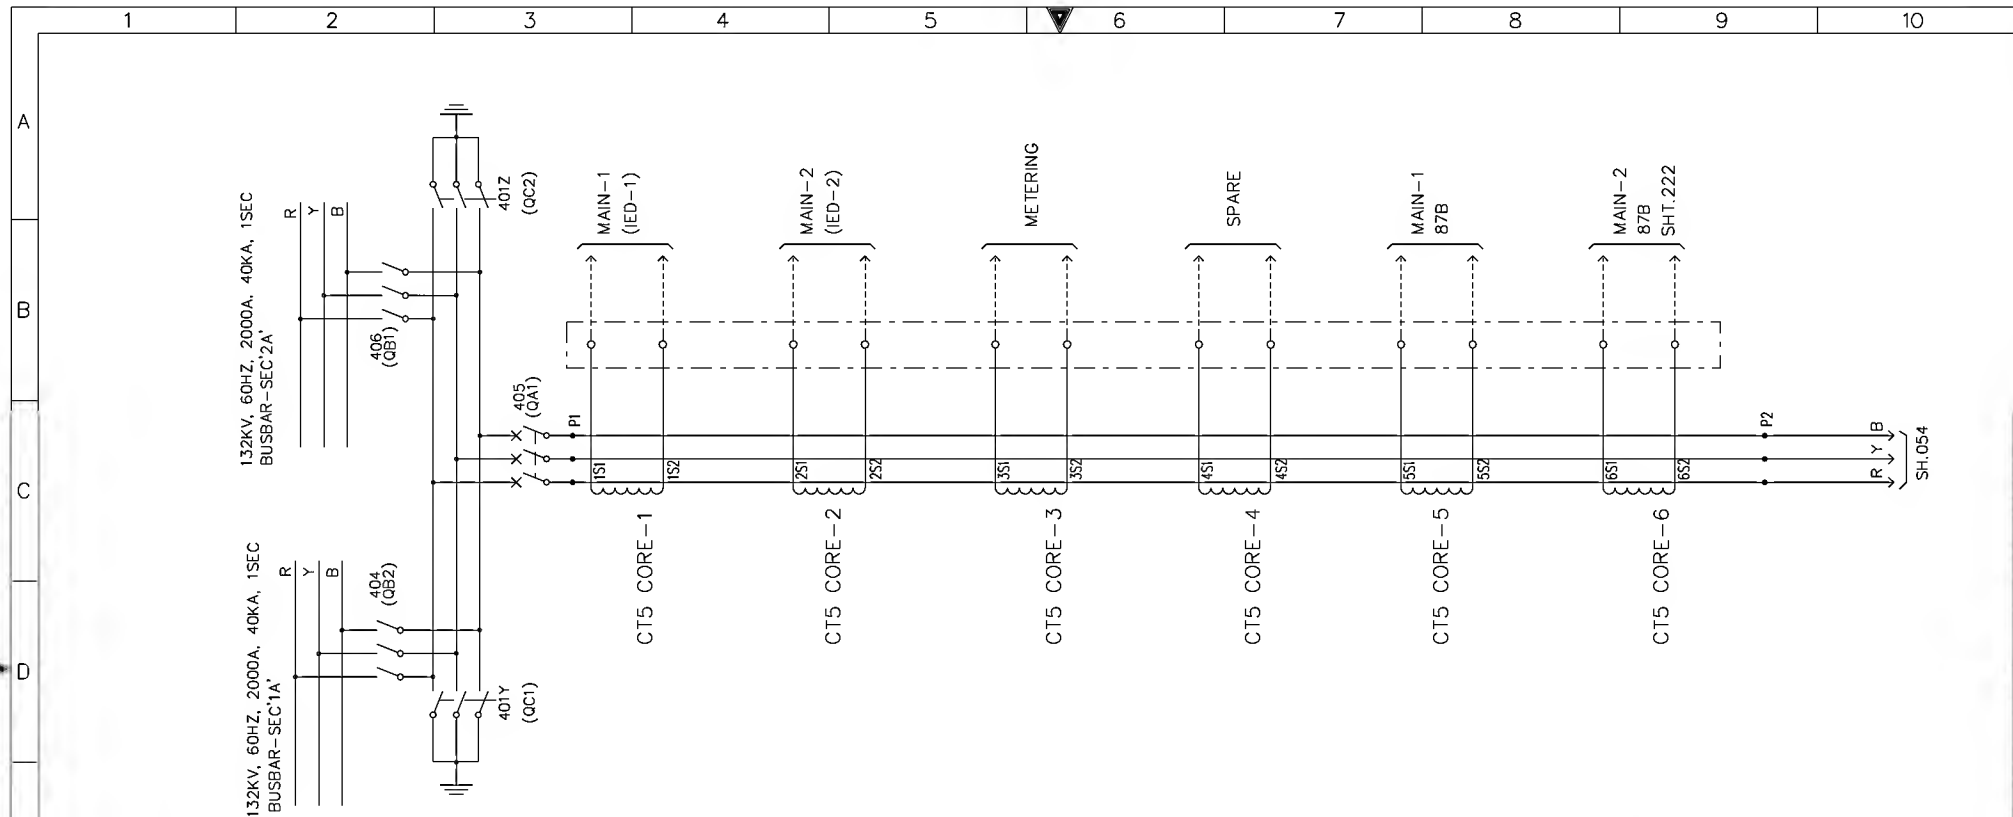




CT	RATIO	CLASS	VK IN VOLTS	IMAG @ VK IN mA	RCT IN (OHMS)	BURDEN IN VA	FUNCTION
CT5-1	300/1A	X	>360	≤50	≤1	-	MAIN-1(IED-1) TRAFO PROTN.
CT5-2	300/1A	X	>360	≤50	≤1	-	MAIN-2(IED-2) TRAFO PROTN.
CT5-3	300/1A	0.2Fs5	-	-	-	30	METERING
CT5-4	300/1A	5P20	-	-	-	30	SPARE
CT5-5	2000/1A	X	>600	≤25	≤5	-	87B MAIN-1
CT5-6	2000/1A	X	>600	≤25	≤5	-	87B MAIN-2

AS-BUILT BY _____ DATE _____		CONTRACT NO. 1113113/00	JOB ORDER NO. S-13656	PRIMARY SYSTEM (TRANSFORMER- GT3 BAY-004)		الشركة الوطنية لنقل الكهرباء		نقل الكهرباء	
01	13 49	FACTORY ASBUILT FOR APPROVAL	DRAWN BY RIZ CHECKED BY KVR	132KV BUSBAR PROTN.MAIN-2 BU PANEL +BBP2-5		National Grid sa			
00	13 05		DATE STARTED 30.01.2013 DATE COMPLETED _____	S/S 8709 - 132/13.8KV IN AL-KHARJ CITY		INDEX	PLANT NO.	DRAWING NUMBER	SHEET NO.
REV. NO.	DATE	DESCRIPTION	OPRG. DEPT. CTPD ENG. DEPT. AUT-PSAC	RIYADH SAUDI ARABIA		-	C421	CD-323009	053/054

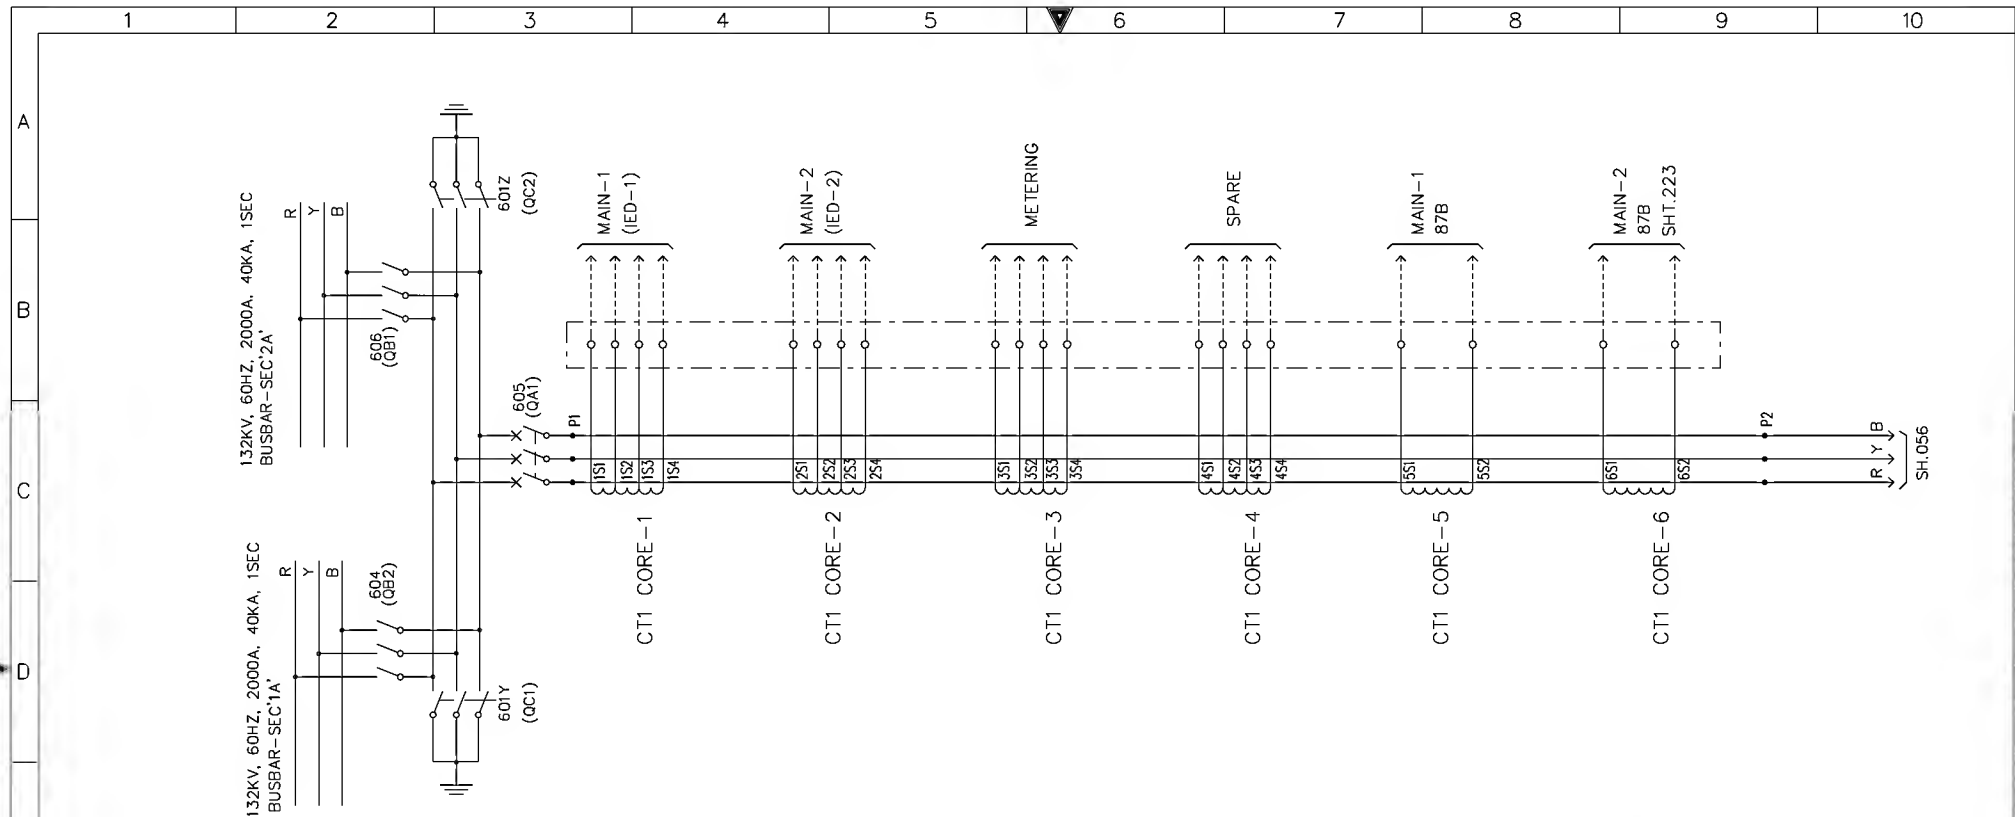


CT	RATIO	CLASS	VK IN VOLTS	IMAG @ VK IN mA	RCT IN (OHMS)	BURDEN IN VA	FUNCTION
CT1-1	1600-1200-800/1A	X	>1400	≤100	≤2	-	MAIN-1(IED-1)
CT1-2	1600-1200-800/1A	X	>1400	≤100	≤2	-	MAIN-2(IED-2)
CT1-3	1600-1200-800/1A	X	>1400	≤100	≤2	-	METERING
CT1-4	1600-1200-800/1A	X	>1400	≤100	≤2	-	SPARE
CT1-5	2000/1A	X	>600	≤25	≤5	-	87B MAIN-1
CT1-6	2000/1A	X	>600	≤25	≤5	-	87B MAIN-2

AS-BUILT BY _____ DATE _____		CONTRACT NO. 1113113/00		JOB ORDER NO. S-13656		PRIMARY SYSTEM (SPARE-2 UGF BAY-D06)		الشركة الوطنية لنقل الكهرباء		نقل الكهرباء	
DRAWN BY RIZ		CHECKED BY KVR		132KV BUSBAR PROTN.MAIN-2 BU PANEL +BBP2-5		S/S 8709 - 132/13.8KV IN AL-KHARJ CITY		INDEX		PLANT NO.	
DATE STARTED 30.01.2013		DATE COMPLETED		RIYADH		SAUDI ARABIA		DRAWING NUMBER		CD-323009	
REV. NO.		DATE		DESCRIPTION		PRG. DEPT. CTPD		ENG. DEPT. AUT-PSAC		SHEET NO.	
01		13 49		FACTORY ASBUILT						SHT CONT.	
00		13 05		FOR APPROVAL						055056	
										REV. NO.	
										01	

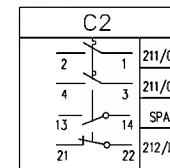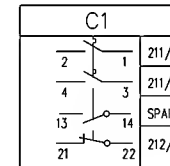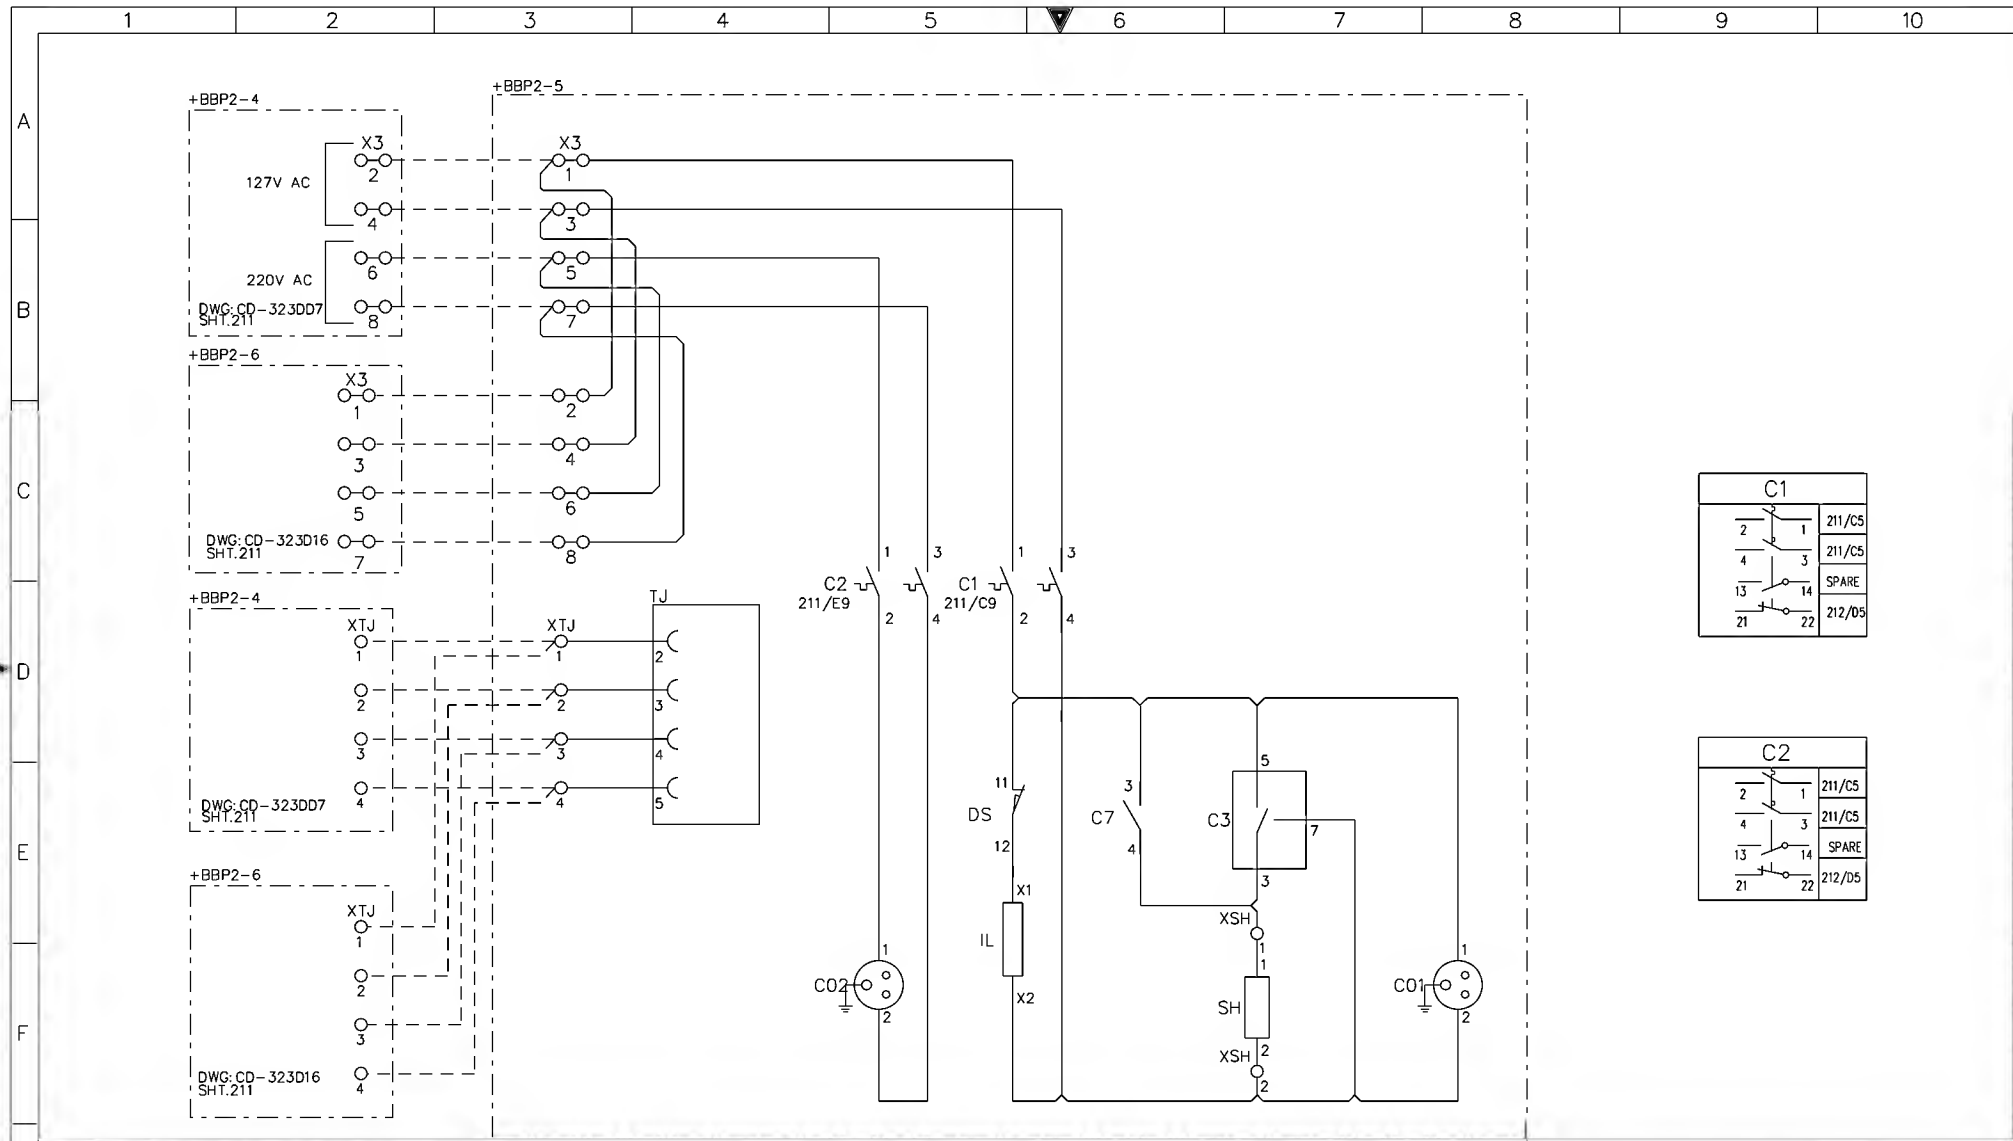

AS-BUILT BY _____ DATE _____		CONTRACT NO. 1113113/00	JOB ORDER NO. S-13656	AC SUPPLY FOR ILLUMINATION & POWER SOCKET		الشركة الوطنية لنقل الكهرباء National Grid sa		INDEX		PLANT NO.		DRAWING NUMBER		SHEET NO.		REV. NO.	
01	13 49	FACTORY ASBUILT		DRAWN BY RIZ	CHECKED BY KVR												
00	13 05	FOR APPROVAL		DATE STARTED 30.01.2013 DATE COMPLETED _____		132KV BUSBAR PROTN.MAIN-2 BU PANEL +BBP2-5		-		C421		CD-323009		211 212		01	
REV. NO.	DATE	DESCRIPTION		PRG. DEPT. CTPD ENG. DEPT. AUT-PSAC		S/S 8709 - 132/13.8KV IN AL-KHARJ CITY											
						RIYADH											
						SAUDI ARABIA											

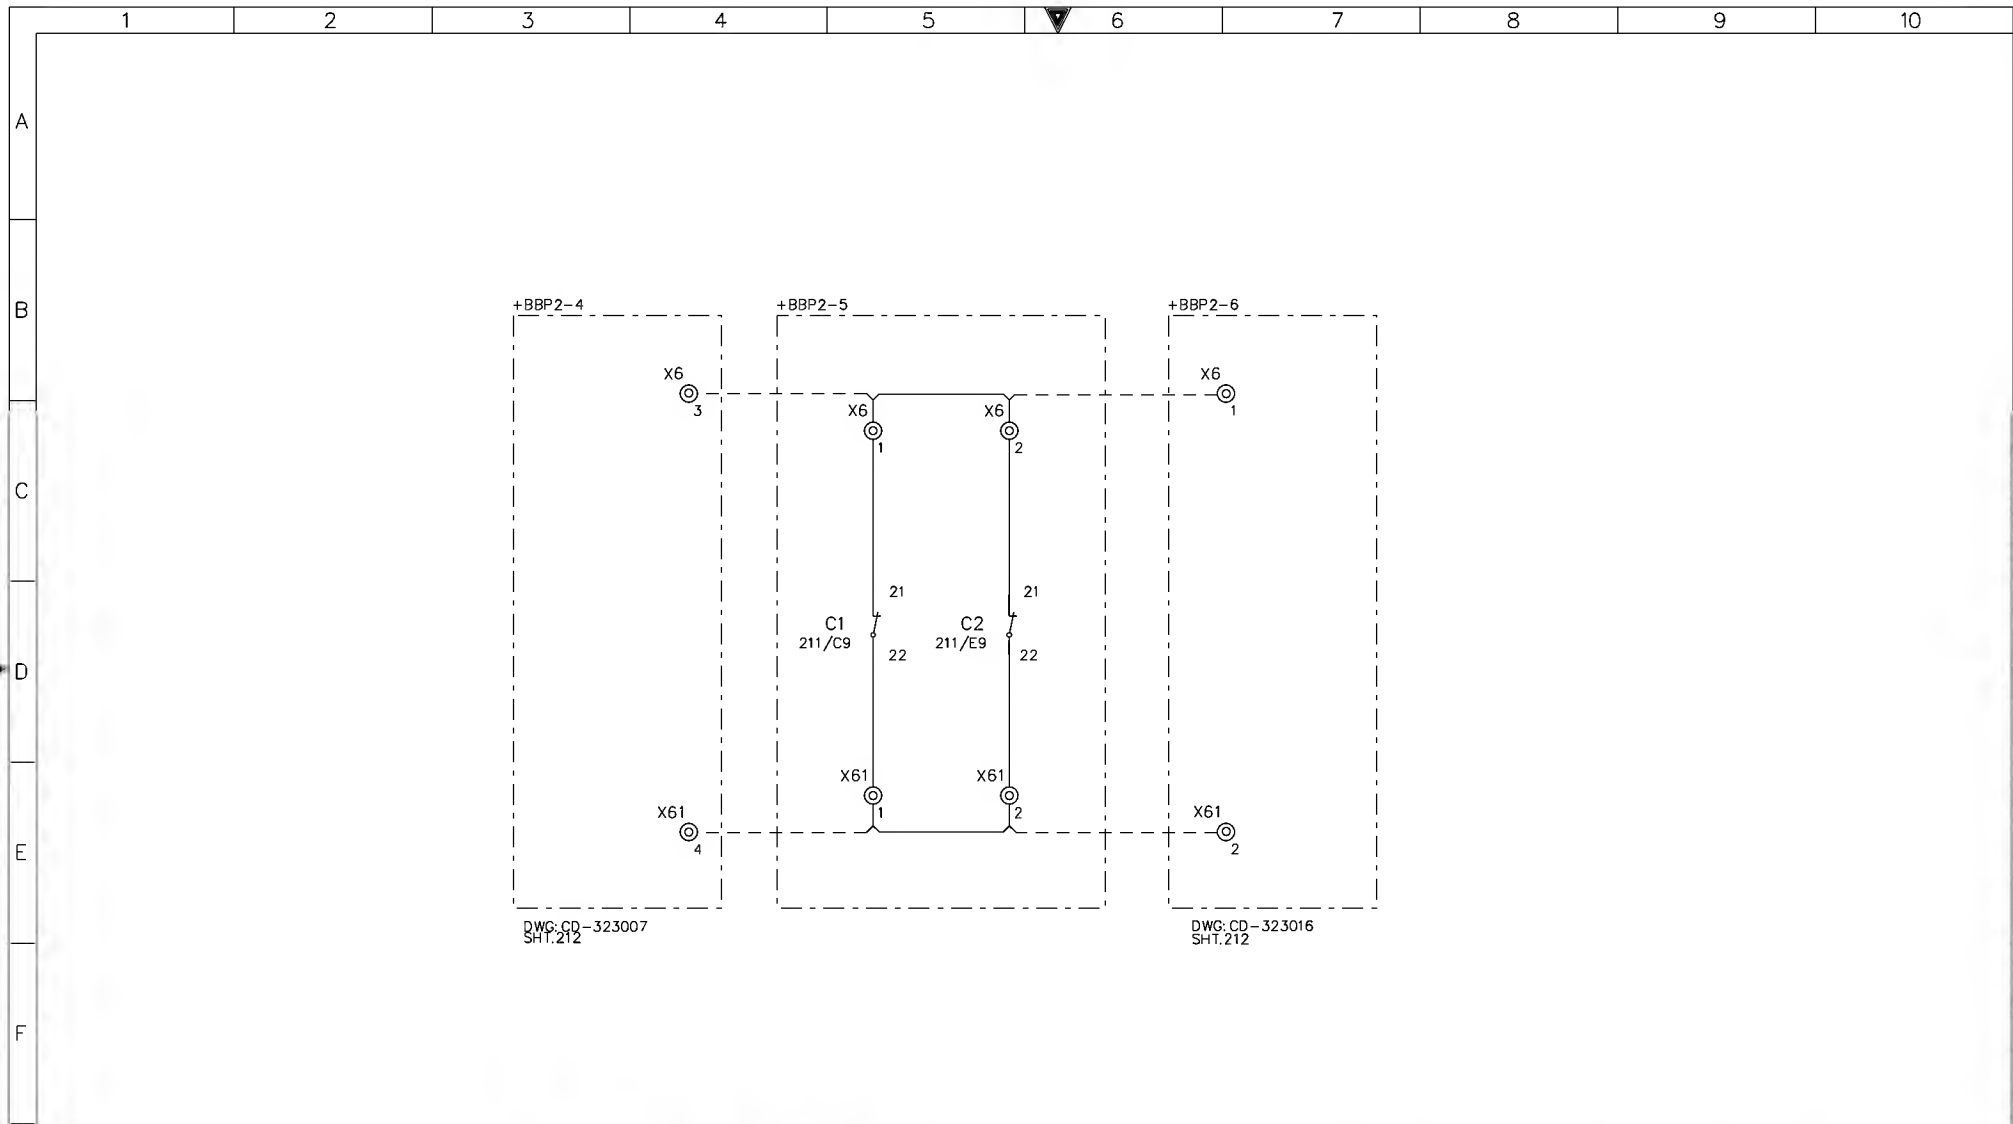





AS-BUILT BY _____ DATE _____			CONTRACT NO. 11131113/00		JOB ORDER NO. S-13656		CUB.LIGHTING,HEATER&SOKET ALARM CKT.			
DRAWN BY RIZ CHECKED BY KVR			DATE STARTED 30.01.2013		DATE COMPLETED _____		132KV BUSBAR PROTN.MAIN-2 BU PANEL +BBP2-5			
FOR APPROVAL			OPRG. DEPT. CTPD		ENG. DEPT. AUT-PSAC		S/S 8709 - 132/13.8KV IN AL-KHARJ CITY			
REV. NO.	DATE	DESCRIPTION					RIYADH		SAUDI ARABIA	

INDEX		PLANT NO.	DRAWING NUMBER	SHEET NO.		REV. NO.
-		C421	CD-323009	SHT	CONT.	01
				212	216	


الشركة الوطنية لنقل الكهرباء
National Grid sa

NG/D2-0 (2012/01)
DMS VECTOR NGD200


THIS DRAWING AND THE INFORMATION CONTAINED HEREIN ARE THE SOLE PROPERTY OF National Grid SA. NO REPRODUCTION IN FULL OR IN PART SHALL BE OBTAINED FROM THIS DOCUMENT WITHOUT THE WRITTEN CONSENT OF ITS OWNER.

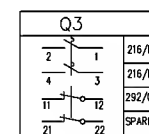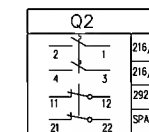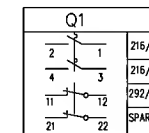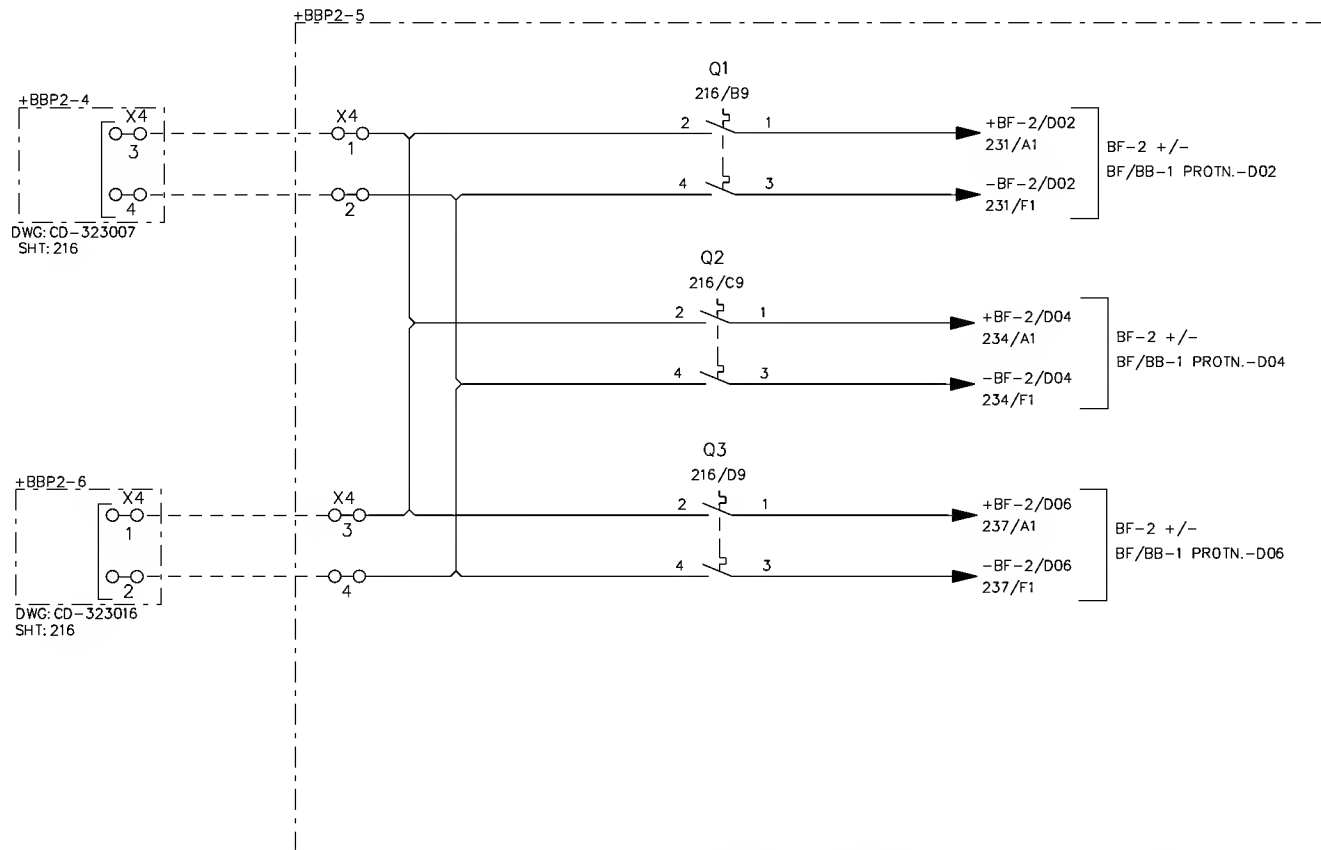

AS-BUILT BY _____ DATE _____			CONTRACT NO. 1113113/00		JOB ORDER NO. S-13656		DC SUPPLY DISTRIBUTION		الشركة الوطنية لنقل الكهرباء		نقل الكهرباء	
01 13 49			DRAWN BY RIZ		CHECKED BY KVR		132KV BUSBAR PROTN.MAIN-2 BU PANEL +BBP2-5		INDEX		PLANT NO.	
00 13 05			DATE STARTED 30.01.2013		DATE COMPLETED		S/S 8709 - 132/13.8KV IN AL-KHARJ CITY		DRAWING NUMBER		SHEET NO.	
REV. NO.			DESCRIPTION		OPRG. DEPT. CTPD		ENG. DEPT. AUT-PSAC		CD-323009		216 221	
							RIYADH SAUDI ARABIA				01	

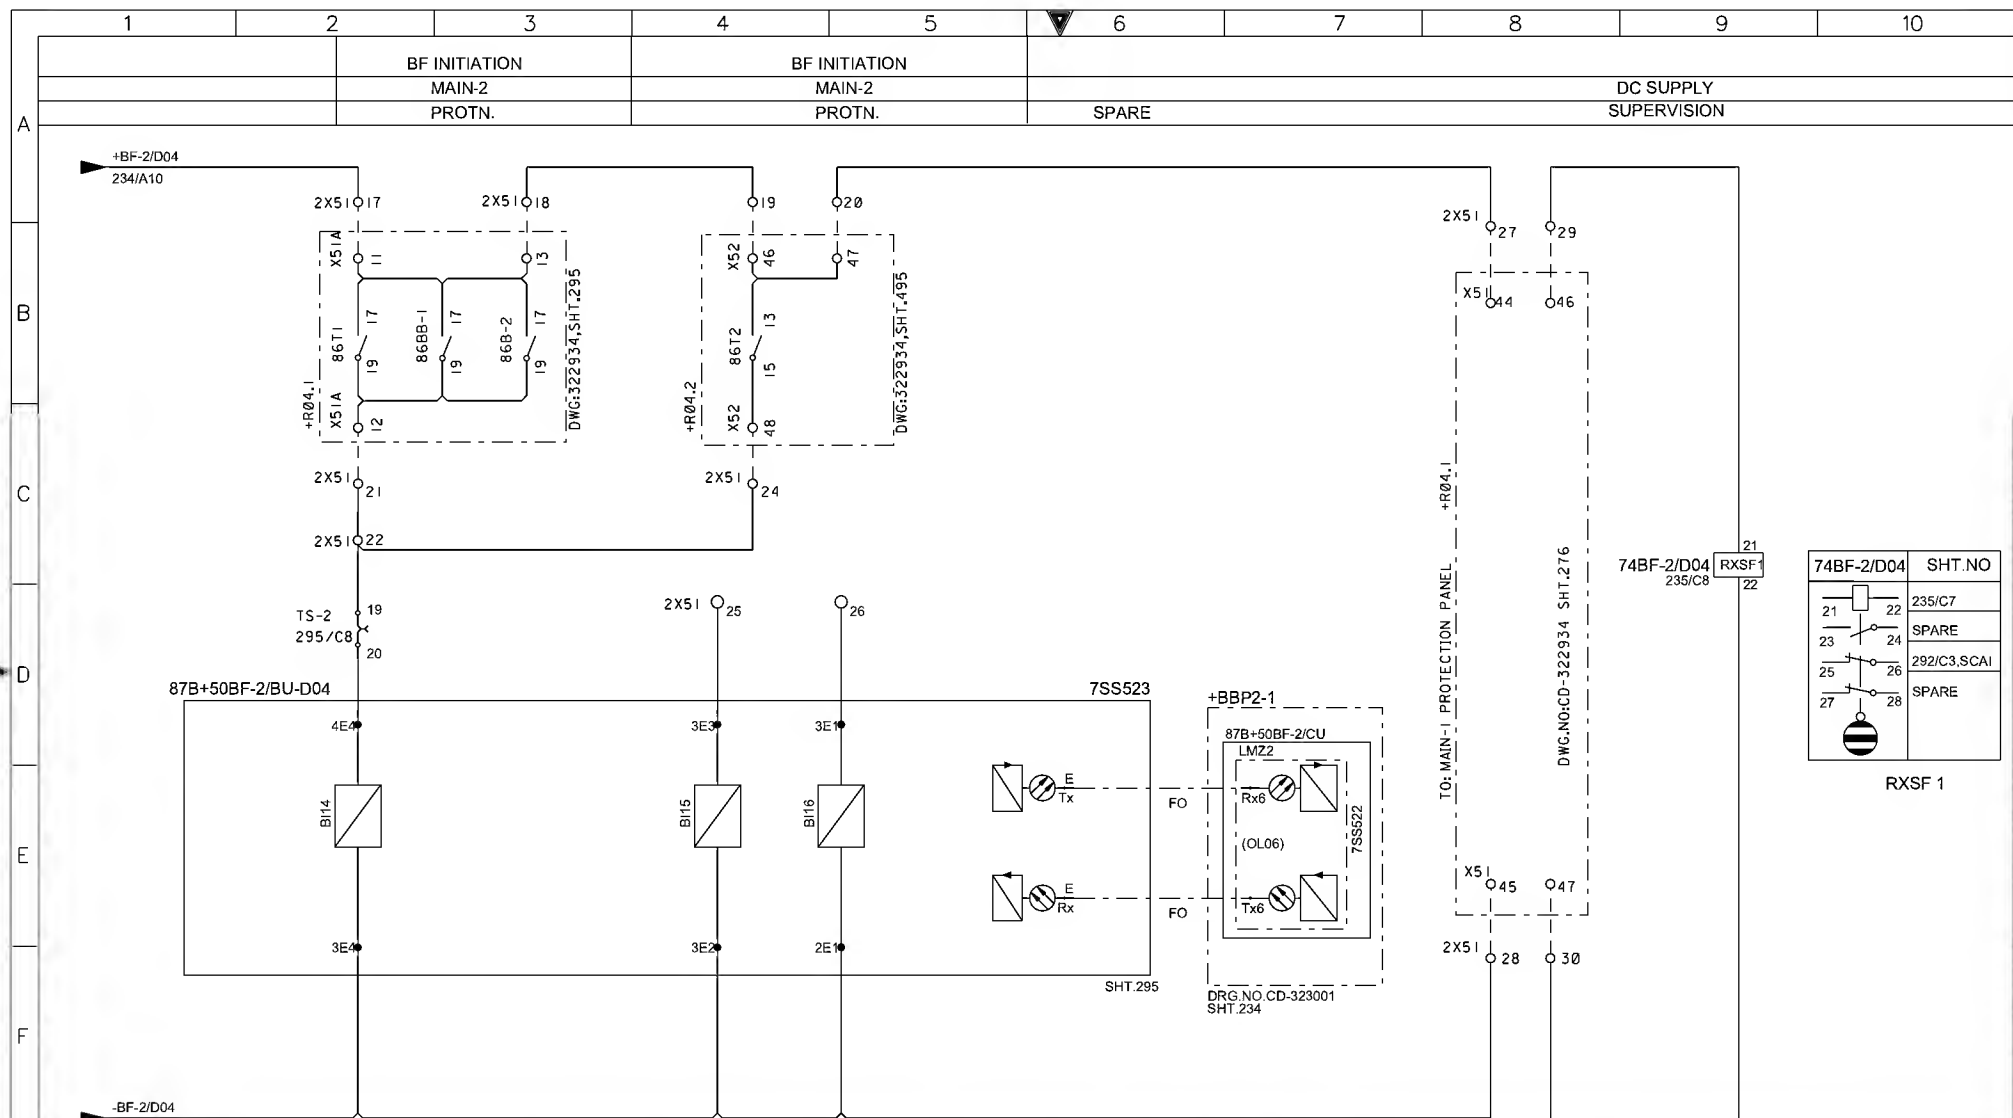



AS-BUILT BY _____ DATE _____			CONTRACT NO. 11131113/00		JOB ORDER NO. S-13656		87B+50BF-2/BU-D04 PROTN. RELAY - BINARY INPUTS			الشركة الوطنية لنقل الكهرباء		
01	13 49	FACTORY ASBUILT	DRAWN BY	RIZ	CHECKED BY	KVR	132KV BUSBAR PROTN. MAIN-2 BU PANEL +BBP2-5			National Grid sa		
00	13 05	FOR APPROVAL	DATE STARTED	30.01.2013	DATE COMPLETED		S/S 8709 - 132/13.8KV IN AL-KHARJ CITY			INDEX PLANT NO. DRAWING NUMBER SHEET NO. REV. NO.		
REV. NO.	DATE	DESCRIPTION	OPRG. DEPT.	CTPD	ENG. DEPT.	AUT-PSAC	RIYADH SAUDI ARABIA			- C421 CD-323009 235/236 01		

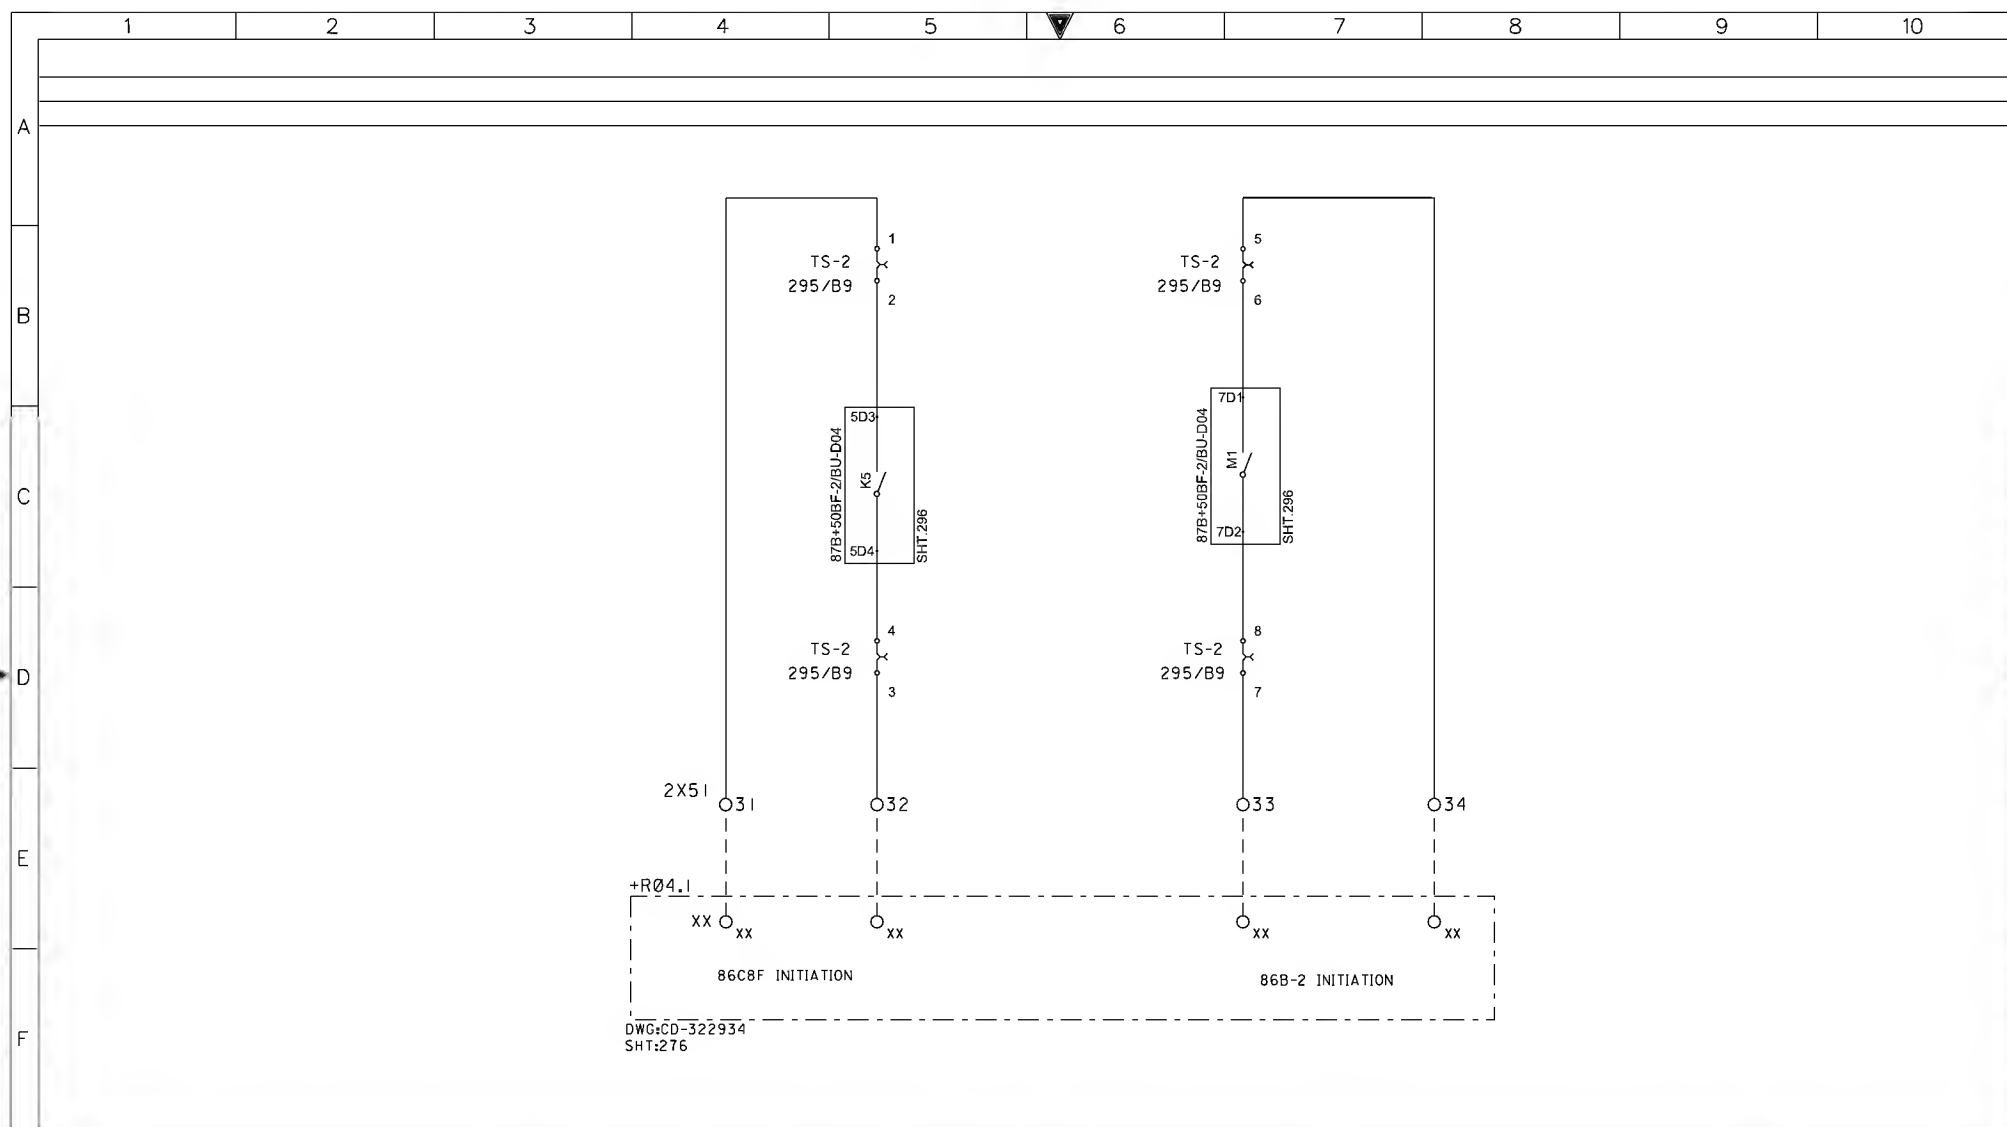

AS-BUILT BY _____ DATE _____			CONTRACT NO. 11131113/00		JOB ORDER NO. S-13656		CBF + BUSBAR PROTN.-2 TRIP RELAY CIRCUIT -004			الشركة الوطنية لنقل الكهرباء National Grid SA															
G	01	13 49	FACTORY ASBUILT		DRAWN BY _____ RIZ _____ CHECKED BY _____ KVR		132KV BUSBAR PROTN.MAIN-2 BU PANEL +BBP2-5			INDEX		PLANT NO.		DRAWING NUMBER		SHEET NO.		REV. NO.							
	00	13 05	FOR APPROVAL		DATE STARTED 30.01.2013 DATE COMPLETED _____		S/S 8709 - 132/13.8KV IN AL-KHARJ CITY			-		C421		CD-323009		SHT CONT.		01							
	REV. NO.	DATE		DESCRIPTION		OPRG. DEPT. _____ CTPD _____ ENG. DEPT. _____ AUT-PSAC		RIYADH SAUDI ARABIA																	
																		DMS		VECTOR		NG/D2-D (2012/01)		NGD20	

THIS DRAWING AND THE INFORMATION CONTAINED HEREIN ARE THE SOLE PROPERTY OF National Grid SA. NO REPRODUCTION IN FULL OR IN PART SHALL BE OBTAINED FROM THIS DOCUMENT WITHOUT THE WRITTEN CONSENT OF ITS OWNER.

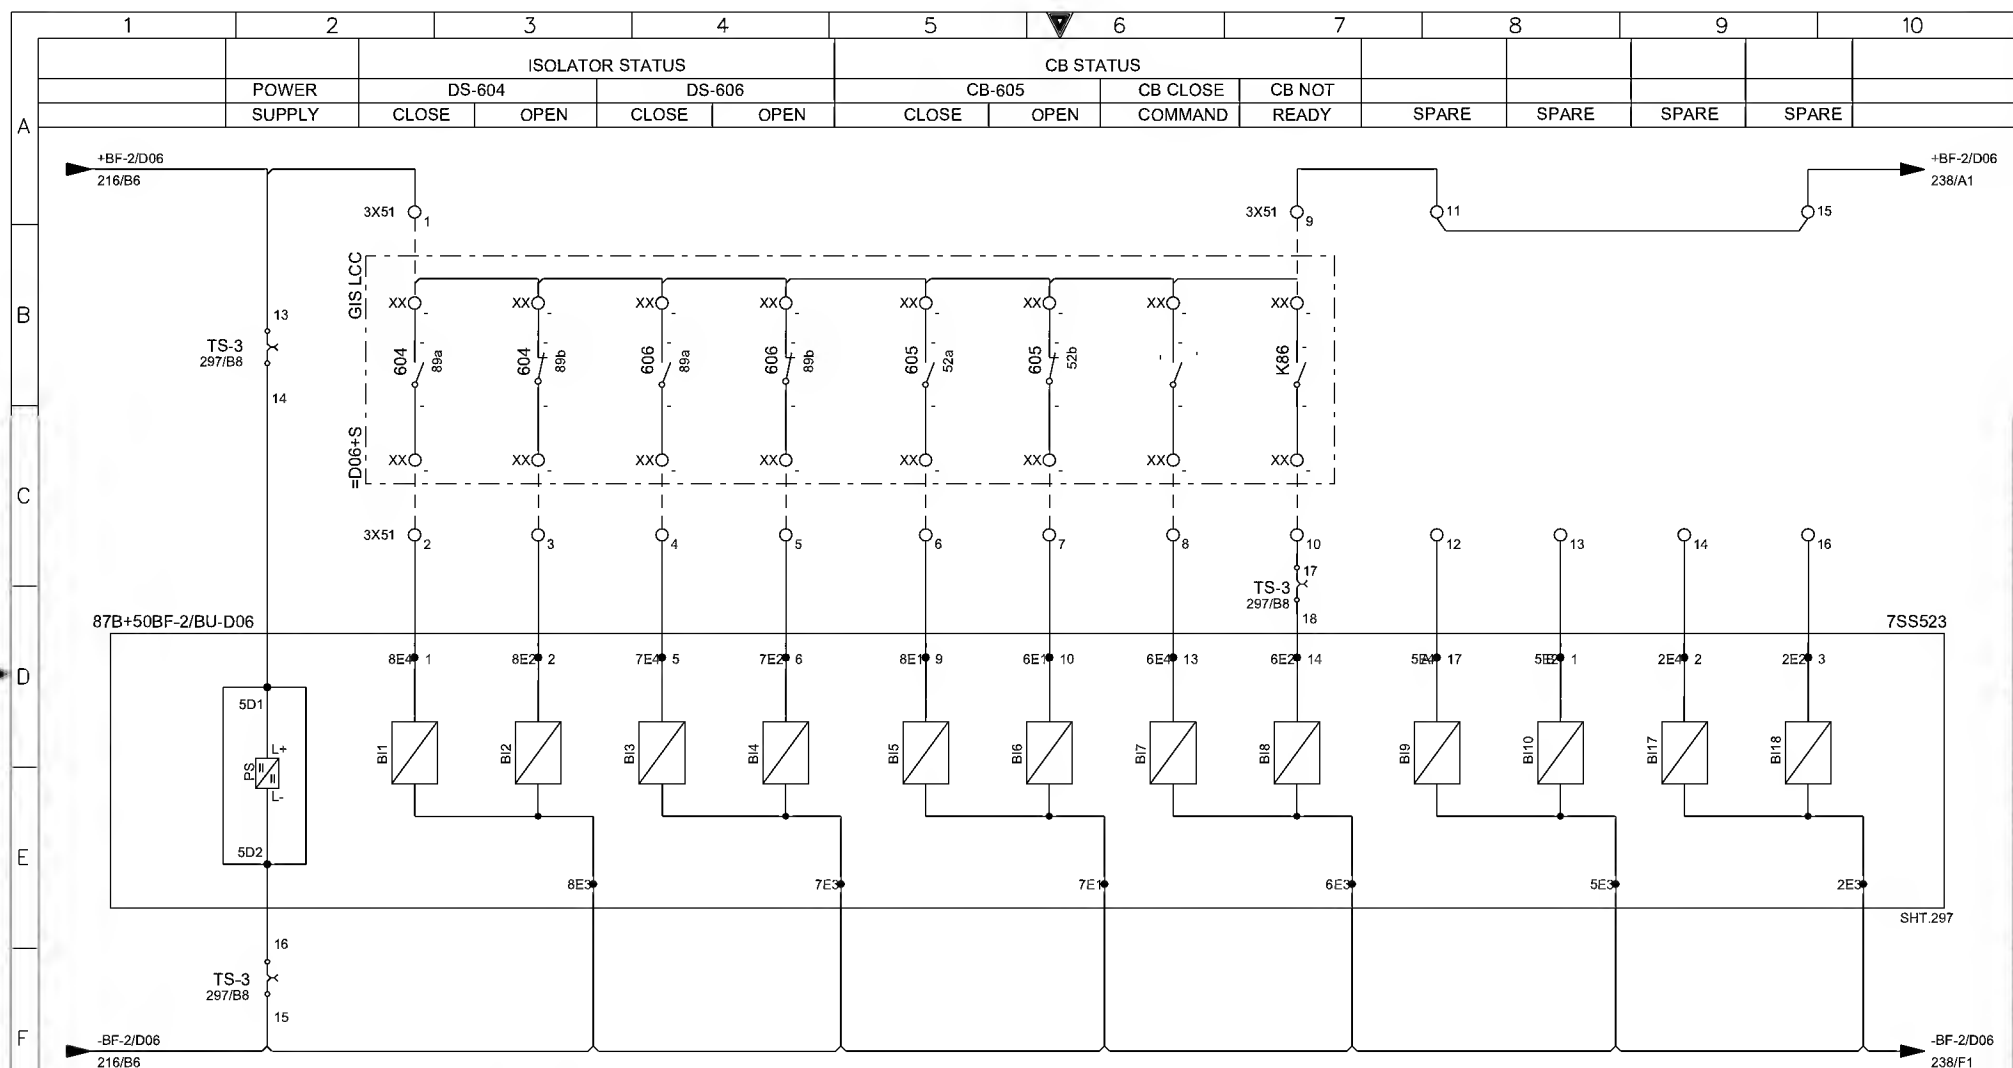

AS-BUILT BY _____ DATE _____			CONTRACT NO. 11131113/00		JOB ORDER NO. S-13656		87B+50BF-2/BU-D06 PROTN.RELAY - BINARY INPUTS		<div>نقل الكهرباء</div> <div>الشركة الوطنية لنقل الكهرباء</div> <div>National Grid sa</div> <div></div>				
G	01		13 49	FACTORY ASBUILT		DRAWN BY RIZ CHECKED BY KVR		132KV BUSBAR PROTN.MAIN-2 BU PANEL +BBP2-5					
	00		13 05	FOR APPROVAL		DATE STARTED 30.01.2013 DATE COMPLETED _____		S/S 8709 - 132/13.8KV IN AL-KHARJ CITY					
	REV. NO.		DATE		DESCRIPTION		OPRG. DEPT. CTPD ENG. DEPT. AUT-PSAC		RIYADH SAUDI ARABIA				

INDEX

PLANT NO.

DRAWING NUMBER

SHEET NO.

REV. NO.

-

C421

CD-323009

237/238


01

NG/02-0 (2012/01)

DMS


VECTOR

NG0200

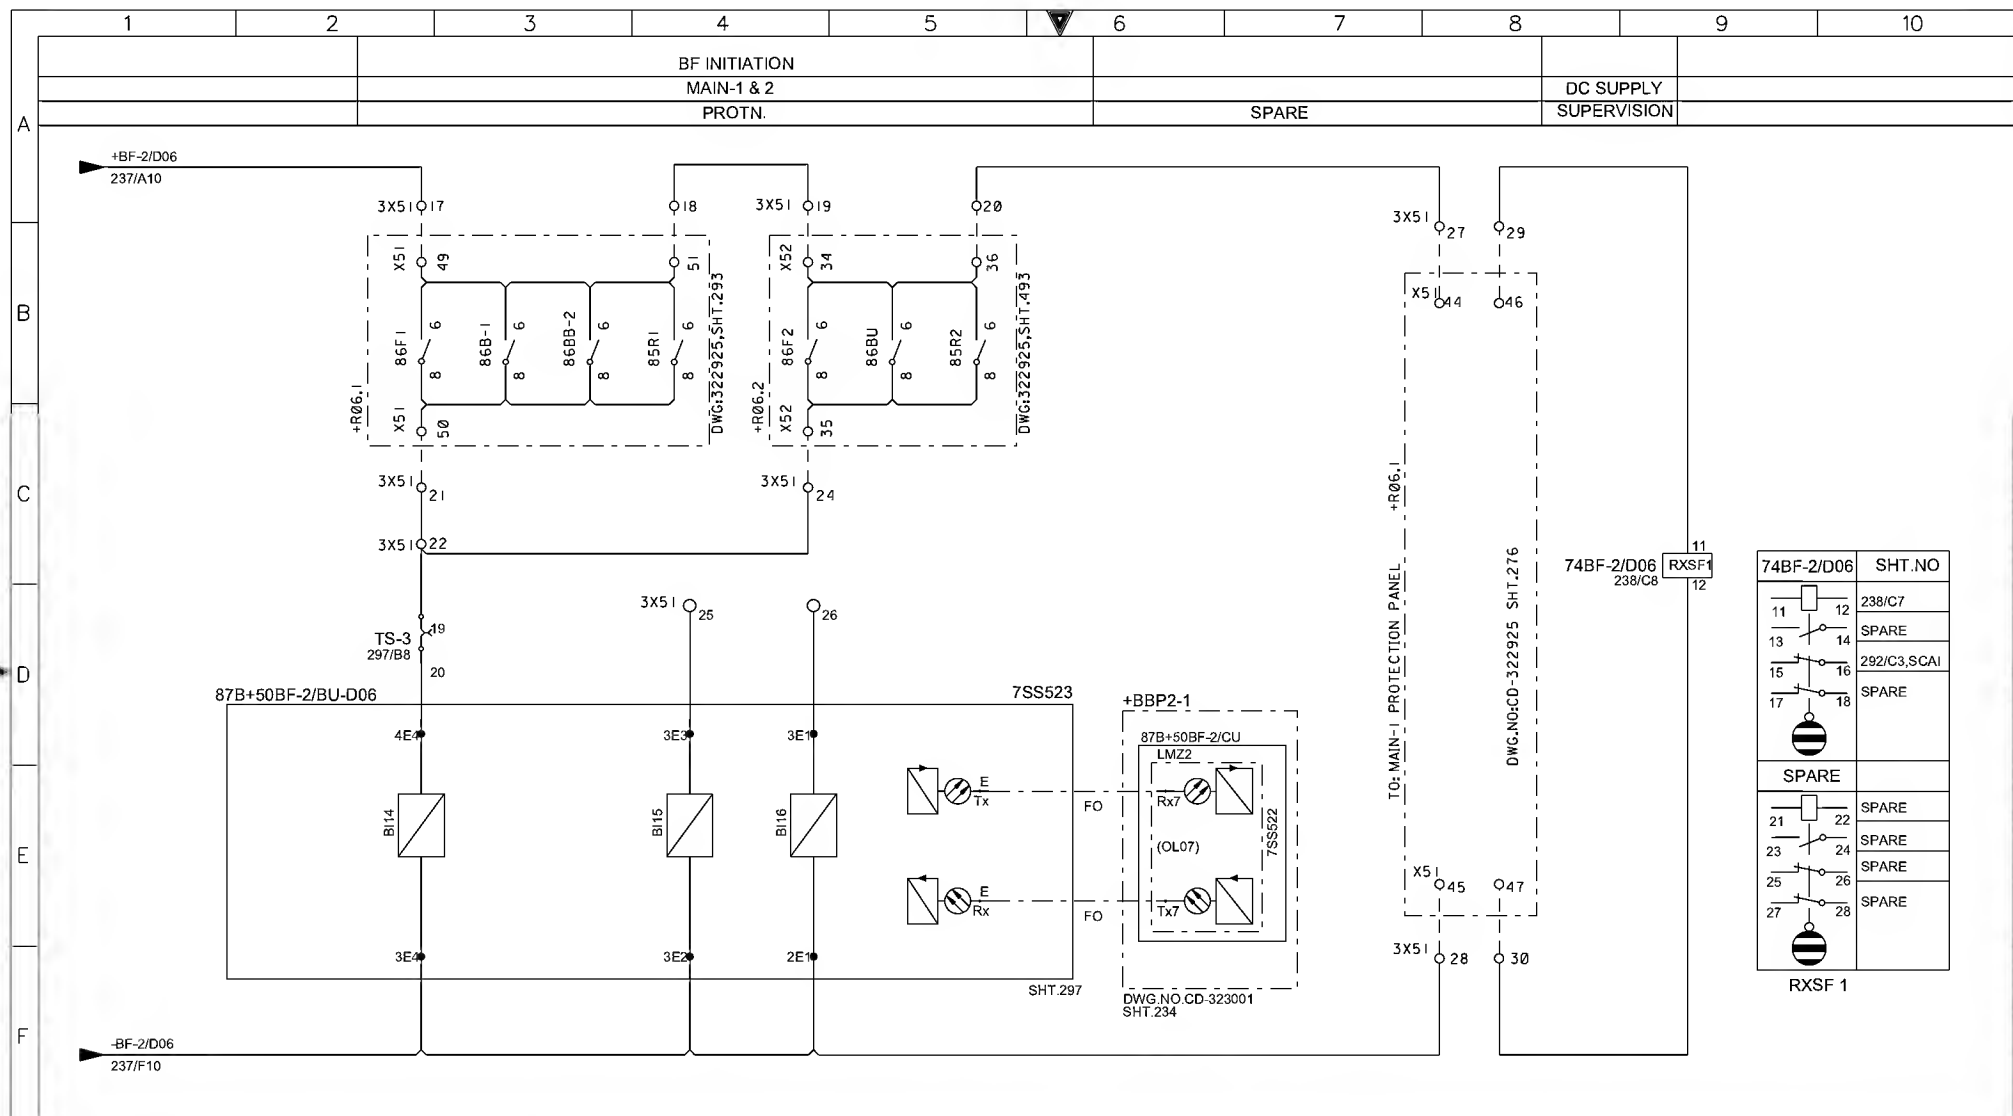


AS-BUILT BY _____ DATE _____		CONTRACT NO. 1113113/00	JOB ORDER NO. S-13656	87B+50BF-2/BU-D06 PROTN. RELAY - BINARY INPUTS		الشركة الوطنية لنقل الكهرباء		نقل الكهرباء	
DRAWN BY RIZ CHECKED BY KVR		DATE STARTED 30.01.2013 DATE COMPLETED _____		132KV BUSBAR PROTN. MAIN-2 BU PANEL +BBP2-5		National Grid sa		SHEET NO. 238/239	
FOR APPROVAL		PRG. DEPT. CTPD ENG. DEPT. AUT-PSAC		S/S 8709 - 132/13.8KV IN AL-KHARJ CITY		INDEX PLANT NO. C421		DRAWING NUMBER CD-323009	
REV. NO. 01		DATE 13 49		FACTORY ASBUILT		- C421		SHT. CONT. 238/239	
00		13 05		FOR APPROVAL		SAUDI ARABIA		REV. NO. 01	
								NG/D2-D (2012/01)	
								VECTOR	
								NGD200	

THIS DRAWING AND THE INFORMATION CONTAINED HEREIN ARE THE SOLE PROPERTY OF National Grid SA. NO REPRODUCTION IN FULL OR IN PART SHALL BE OBTAINED FROM THIS DOCUMENT WITHOUT THE WRITTEN CONSENT OF ITS OWNER.

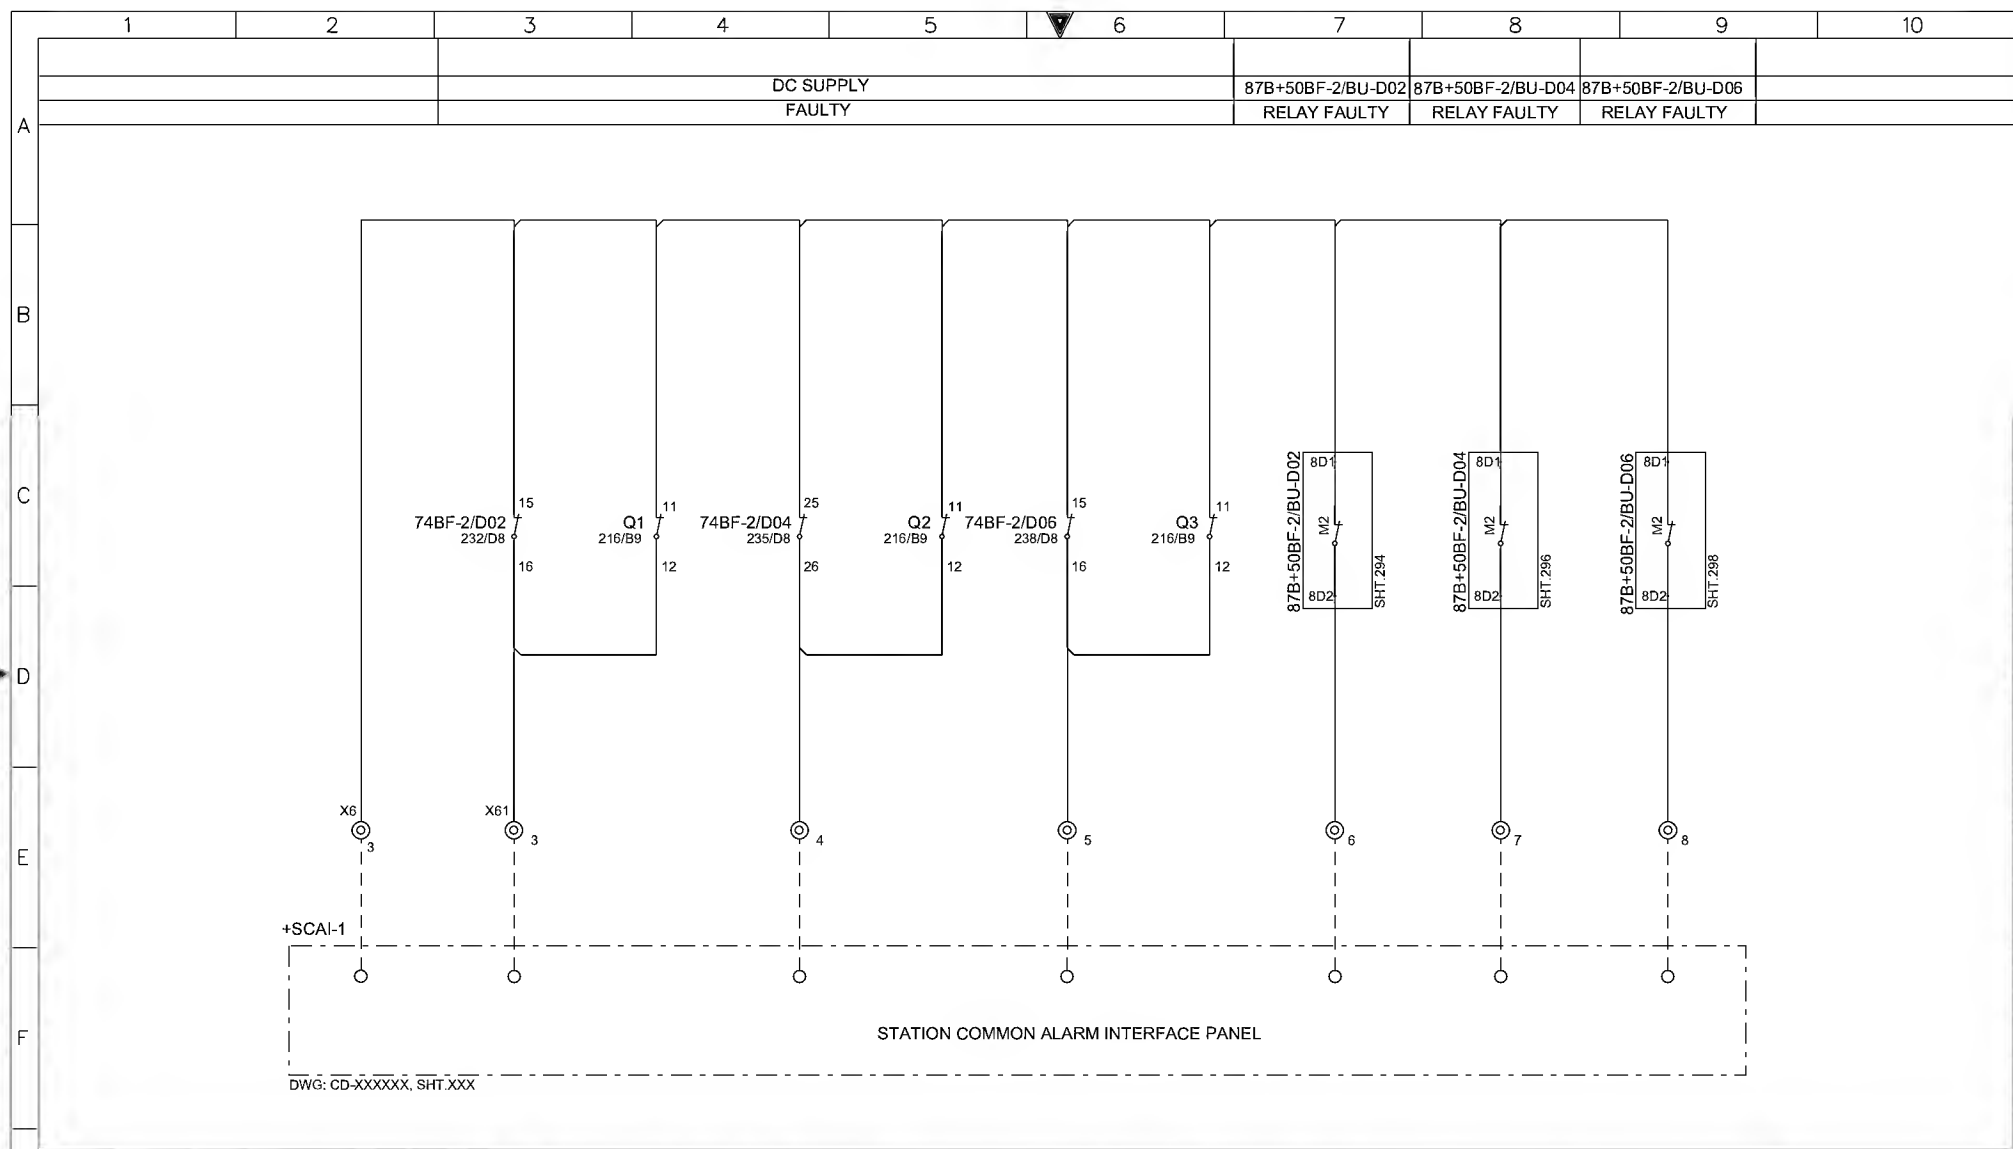

AS-BUILT BY _____ DATE _____			CONTRACT NO. 11131113/00		JOB ORDER NO. S-13656		COMMON ALARM CIRCUITS			الشركة الوطنية لنقل الكهرباء		
DRAWN BY RIZ CHECKED BY KVR			DATE STARTED 30.01.2013		DATE COMPLETED _____		132KV BUSBAR PROTN.MAIN-2 BU PANEL +BBP2-5			National Grid sa		
FOR APPROVAL			OPRG. DEPT. CTPD		ENG. DEPT. AUT-PSAC		S/S 8709 - 132/13.8KV IN AL-KHARJ CITY			National Grid sa		
REV. NO.	DATE	DESCRIPTION	RIYADH		SAUDI ARABIA		INDEX	PLANT NO.	DRAWING NUMBER	SHEET NO.	REV. NO.	
01	13 49	FACTORY ASBUILT					-	C421	CD-323009	292	01	
00	13 05	FOR APPROVAL								293		

THIS DRAWING AND THE INFORMATION CONTAINED HEREIN ARE THE SOLE PROPERTY OF National Grid SA. NO REPRODUCTION IN FULL OR IN PART SHALL BE OBTAINED FROM THIS DOCUMENT WITHOUT THE WRITTEN CONSENT OF ITS OWNER.

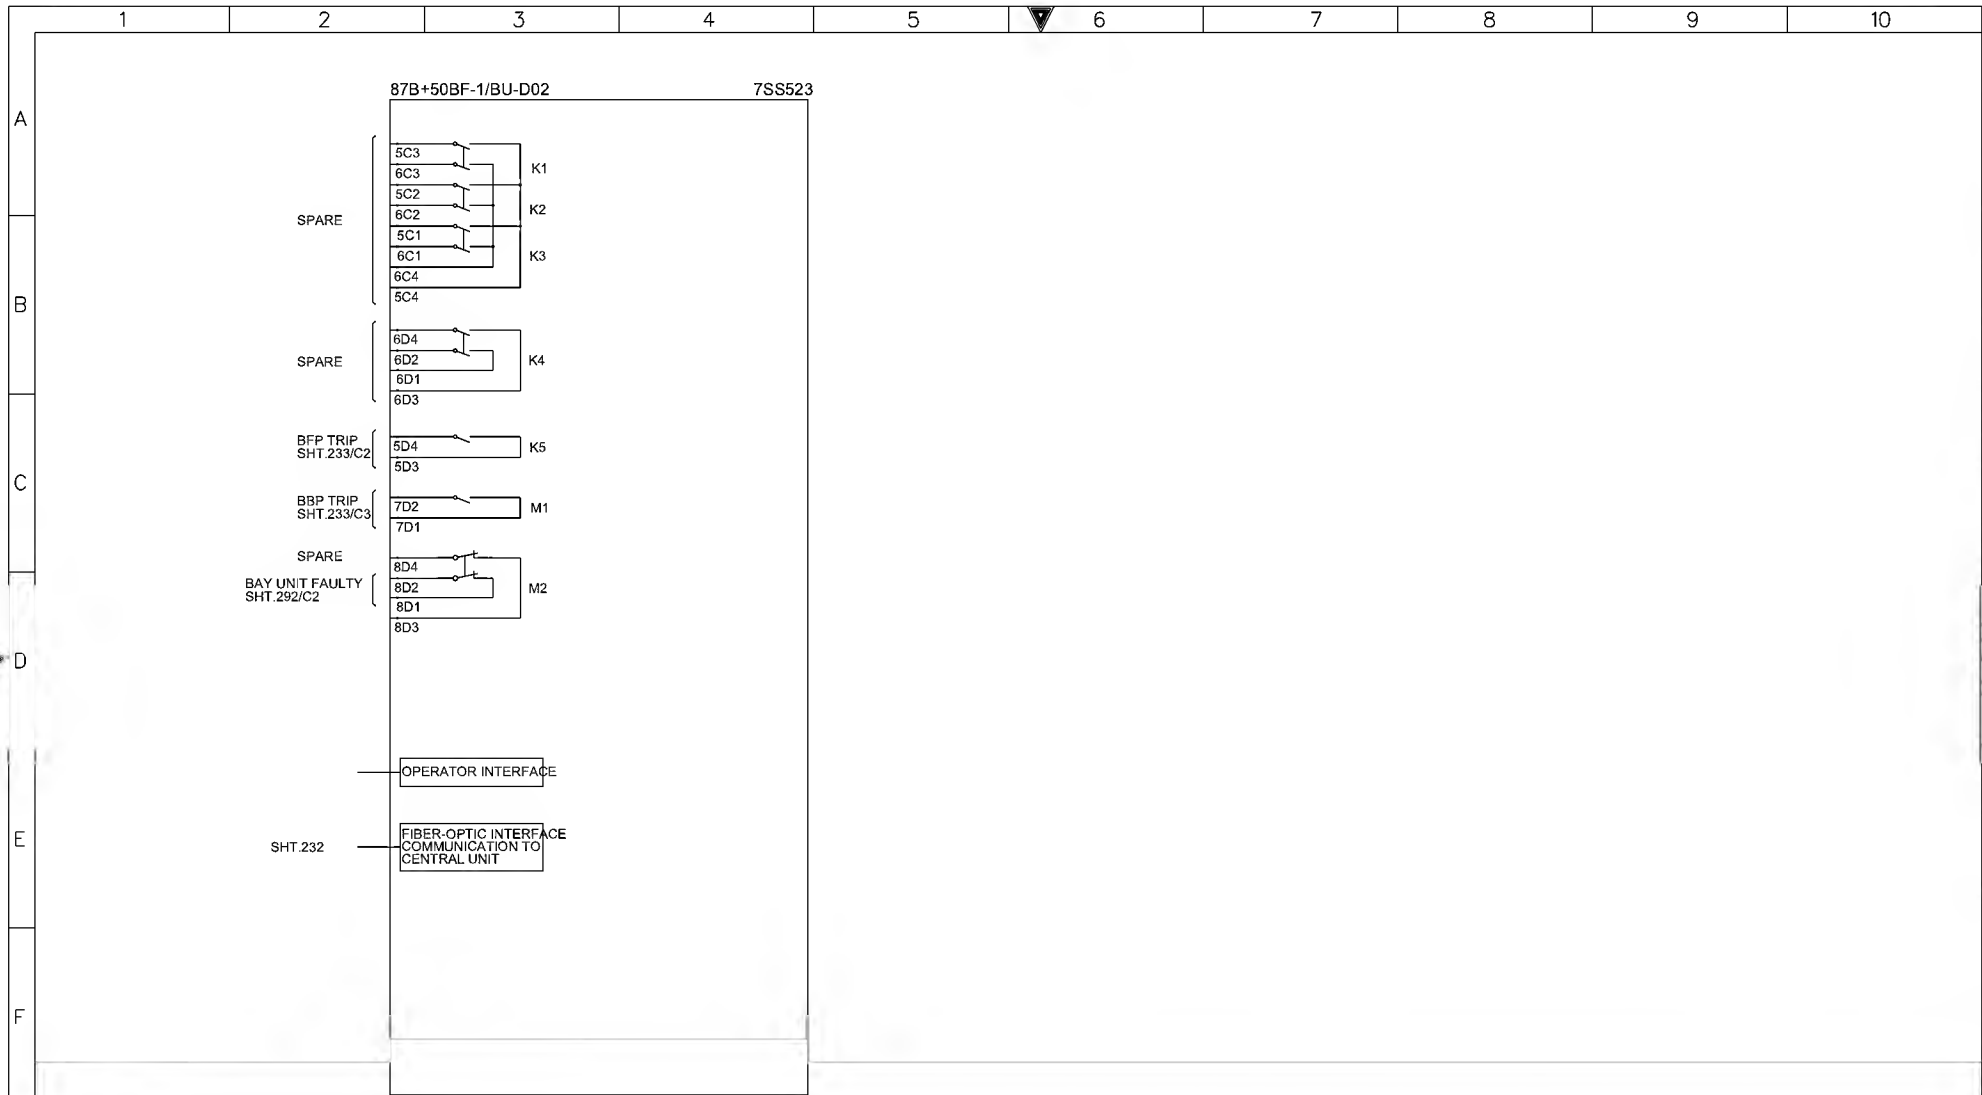

AS-BUILT BY _____ DATE _____ CONTRACT NO. 11131113/00 JOB ORDER NO. S-13656

01 13 49 FACTORY ASBUILT
00 13 05 FOR APPROVAL

DRAWN BY RIZ CHECKED BY KVR

DATE STARTED 30.01.2013 DATE COMPLETED


PRG. DEPT. CTPD ENG. DEPT. AUT-PSAC

87B+50BF-2/BU-D02 INTERNAL DIAGRAM
132KV BUSBAR PROTN.MAIN-2 BU PANEL +BBP2-5
S/S 8709 - 132/13.8KV IN AL-KHARJ CITY
RIYADH SAUDI ARABIA


الشركة الوطنية لنقل الكهرباء
National Grid SA

INDEX	PLANT NO.	DRAWING NUMBER	SHEET NO.	REV. NO.
-	C421	CD-323009	SHT. 294 CONT. 295	01

NG/D2-0 (2012/01)
DMS VECTOR NGD200

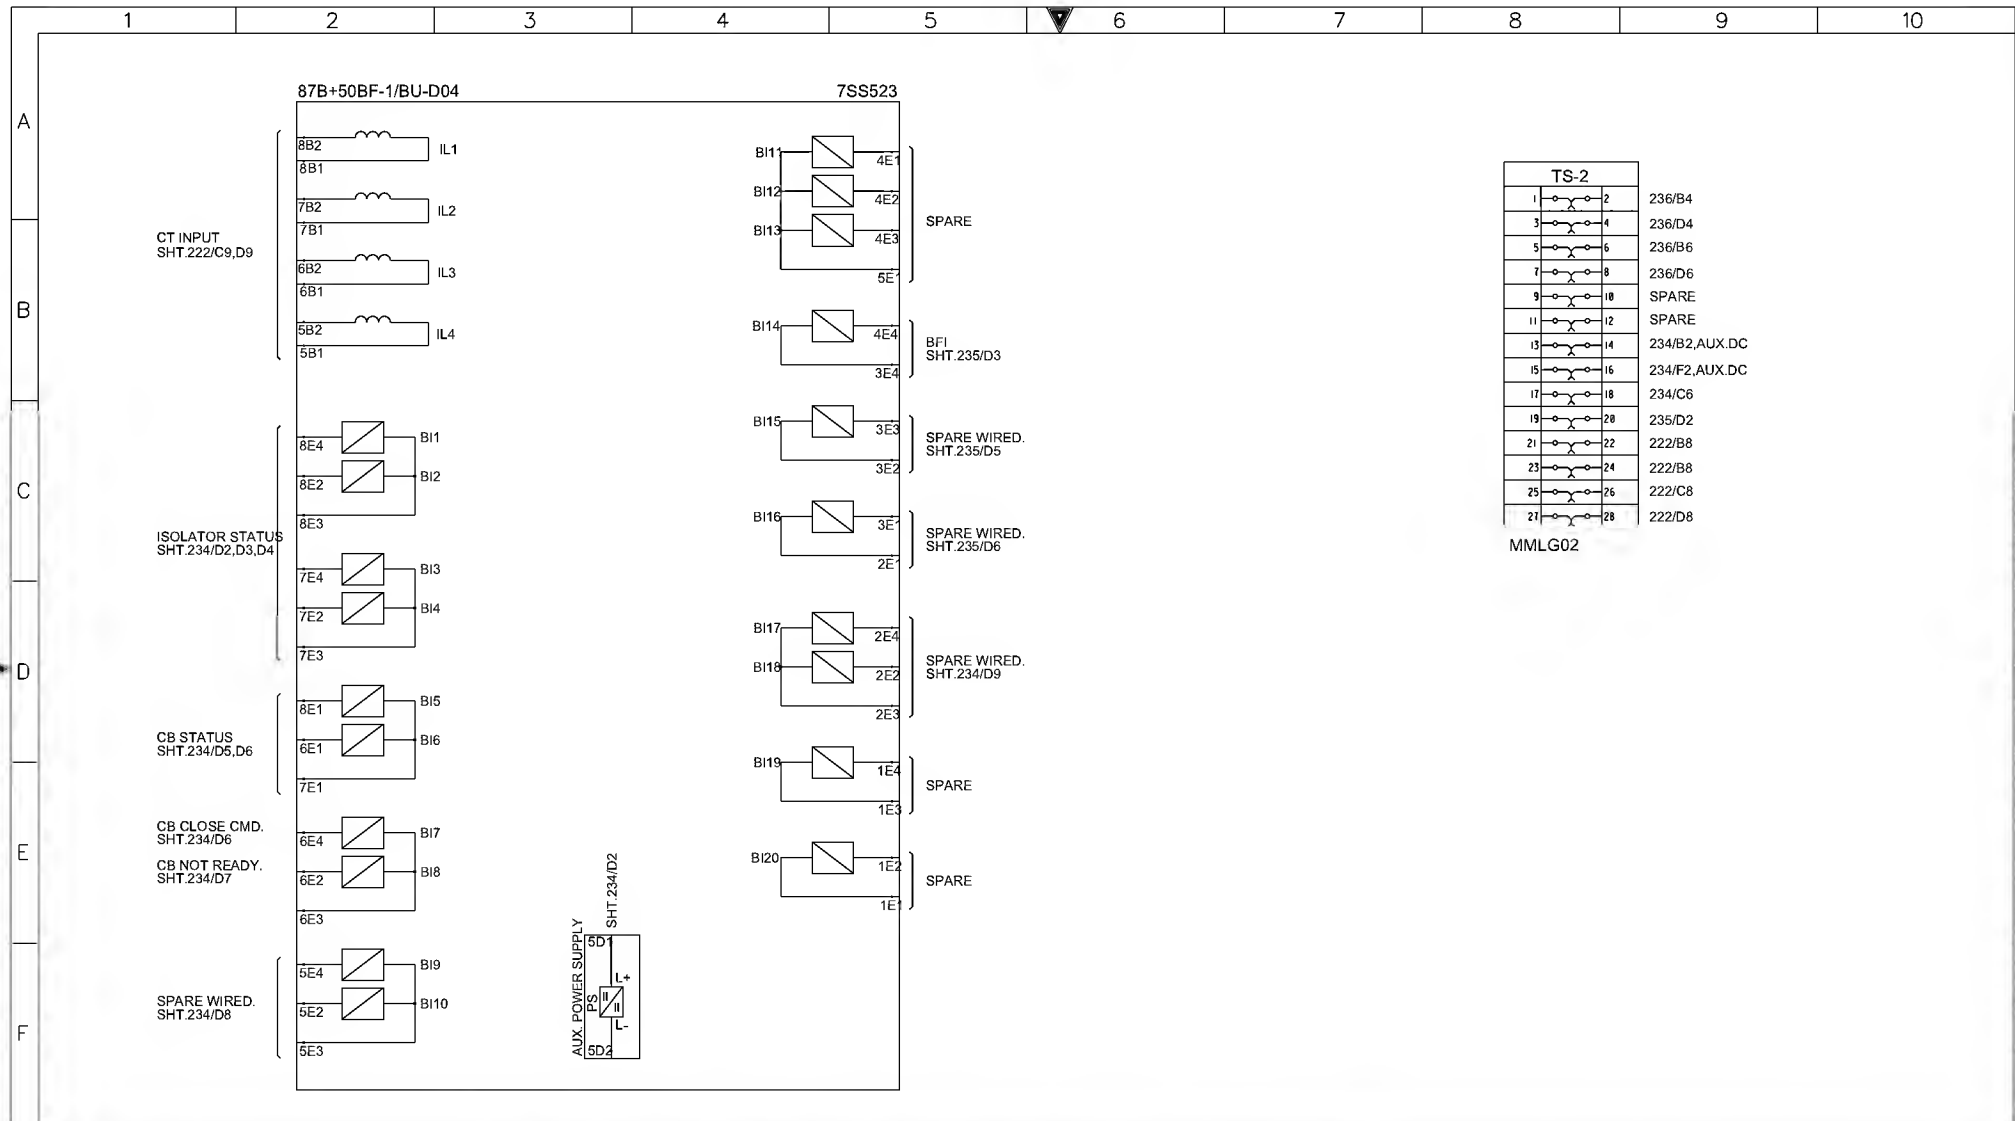

AS-BUILT BY _____ DATE _____			CONTRACT NO. 1113113/00	JOB ORDER NO. S-13656	87B+50BF-2/BU-D04 INTERNAL DIAGRAM	الشركة الوطنية لنقل الكهرباء National Grid sa			
01	13 49	FACTORY ASBUILT	DRAWN BY RIZ	CHECKED BY KVR	132KV BUSBAR PROTN,MAIN-2 BU PANEL +BBP2-5	INDEX	PLANT NO.	DRAWING NUMBER	SHEET NO.
00	13 05	FOR APPROVAL	DATE STARTED 30.01.2013	DATE COMPLETED	S/S 8709 - 132/13.8KV IN AL-KHARJ CITY	-	C421	CD-323009	SHT CONT
REV. NO.	DATE	DESCRIPTION	OPRG. DEPT. CTPD	ENG. DEPT. AUT-PSAC	RIYADH SAUDI ARABIA				295 296

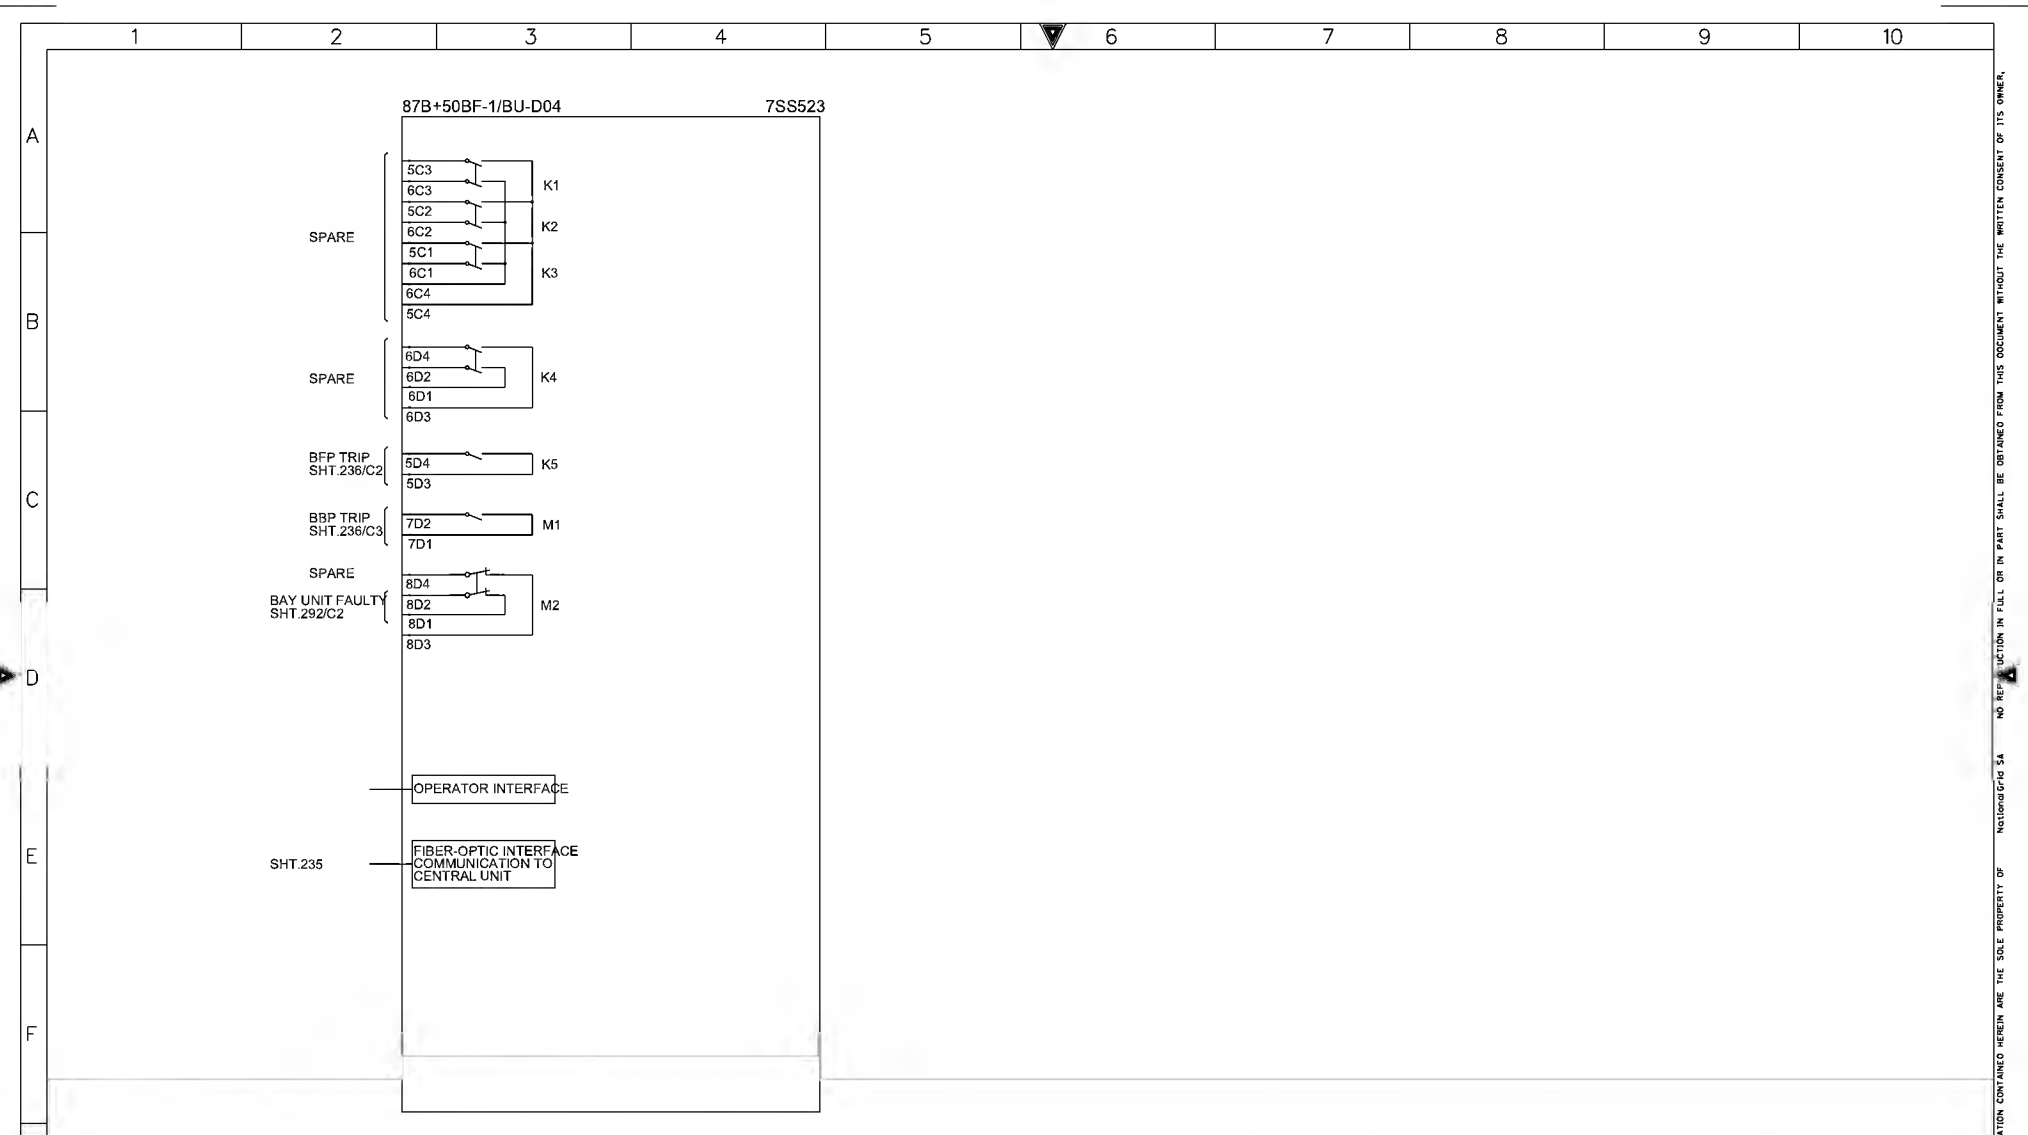

AS-BUILT BY

DATE

CONTRACT NO.

11131113/00

JOB ORDER NO.

S-13656

01

13 49

FACTORY ASBUILT

00

13 05

FOR APPROVAL

REV. NO.

DATE

DESCRIPTION

DRAWN BY

RIZ

CHECKED BY

KVR

DATE STARTED

30.01.2013

DATE COMPLETED

OPRG. DEPT.

CTPD

ENG. DEPT.

AUT-PSAC

87B+50BF-2/BU-D04 INTERNAL DIAGRAM

132KV BUSBAR PROTN.MAIN-2 BU PANEL +BBP2-5

S/S 8709 - 132/13.8KV IN AL-KHARJ CITY

RIYADH SAUDI ARABIA

الشركة الوطنية لنقل الكهرباء

National Grid SA

INDEX

PLANT NO.

DRAWING NUMBER

SHEET NO.

REV. NO.

-

C421

CD-323009

SHT

CONT.

236/297

01


NG/D2-0 (2012/01)

DMS

VECTOR


NGD200

THIS DRAWING AND THE INFO

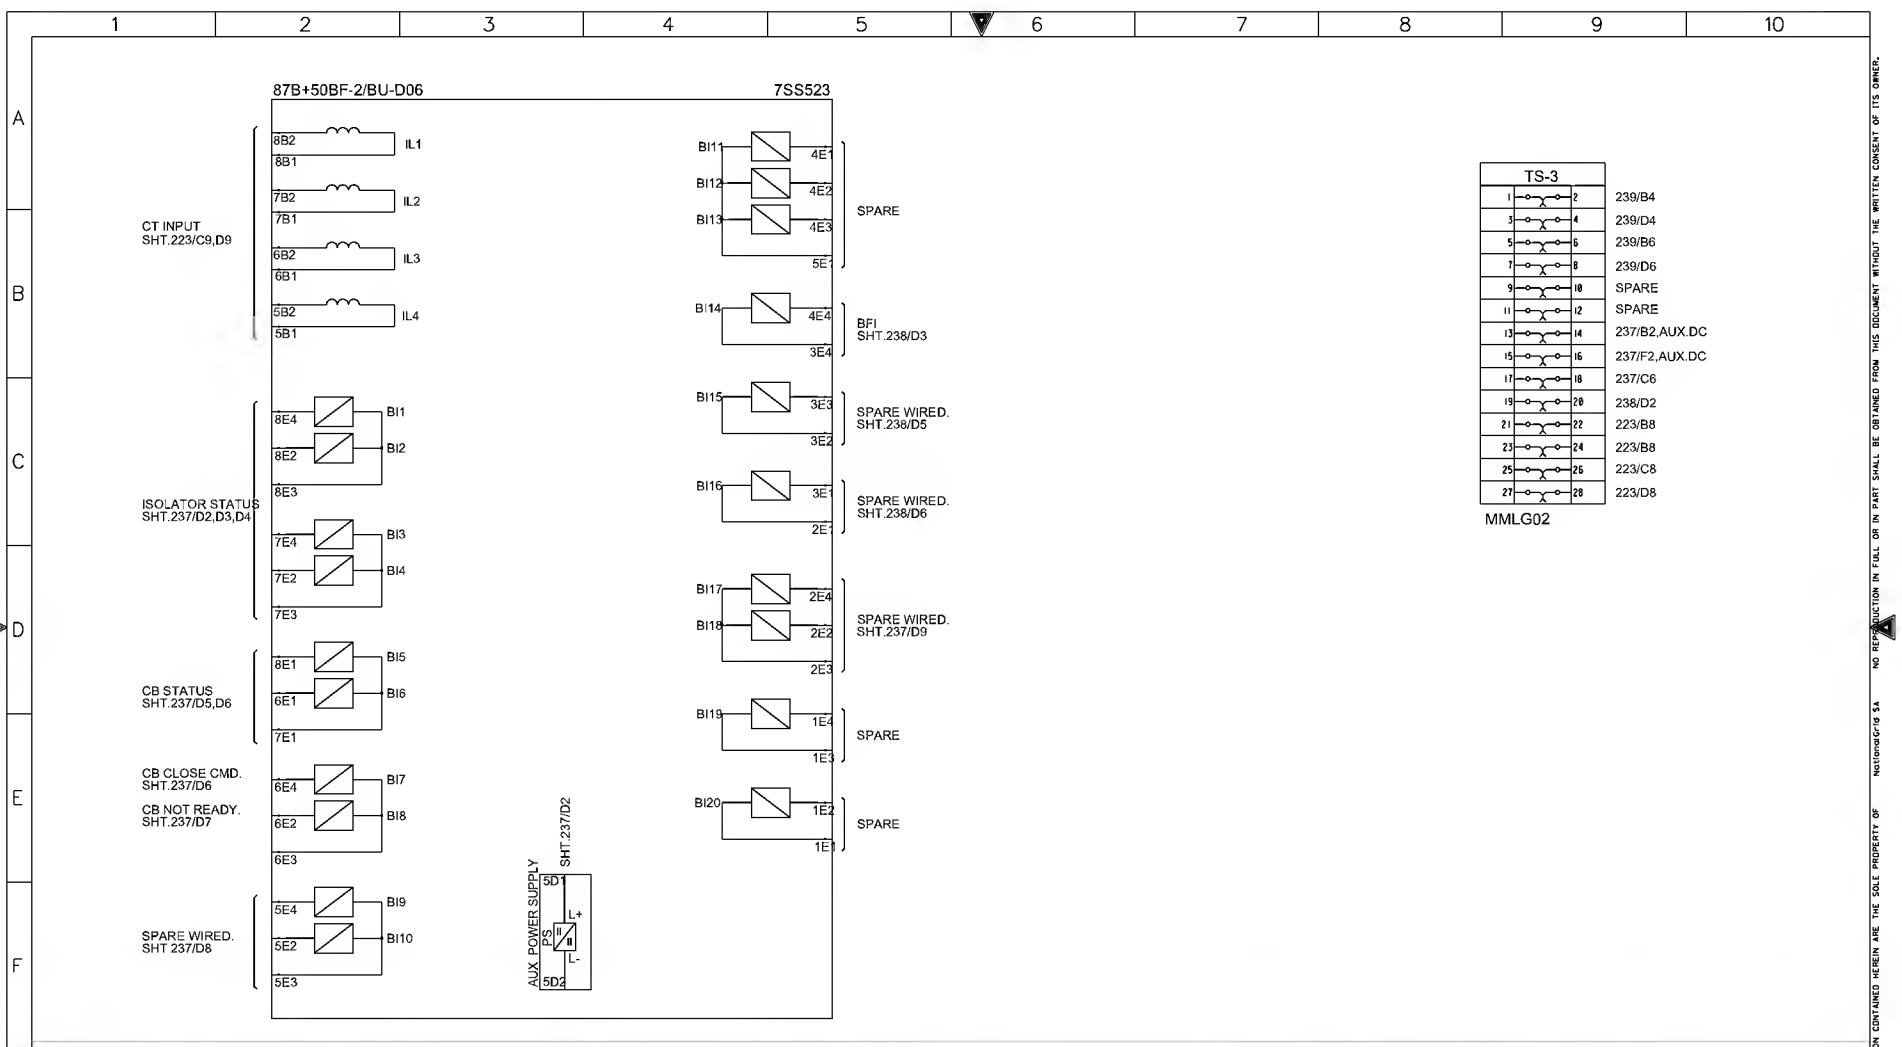

AS-BUILT BY		DATE	CONTRACT NO. 11131113/00	JOB ORDER NO. S-13656	87B+50BF-2/BU-D06 INTERNAL DIAGRAM		الشركة الوطنية لنقل الكهرباء		نقل الكهرباء	
01	13 49	FACTORY ASBUILT	DRAWN BY RIZ	CHECKED BY KVR	132KV BUSBAR PROTN.MAIN-2 BU PANEL +BBP2-5		National Grid SA			
00	13 05	FOR APPROVAL	DATE STARTED 30.01.2013	DATE COMPLETED	S/S 8709 - 132/13.8KV IN AL-KHARJ CITY		INDEX	PLANT NO.	DRAWING NUMBER	SHEET NO.
REV. NO.	DATE	DESCRIPTION	OPRG. DEPT. CTPD	ENG. DEPT. AUT-PSAC	RIYADH SAUDI ARABIA		-	C421	CD-323009	297/298
									REV. NO.	01
									NG/D2-D (2012/01)	
									DMS	VECTOR
									NCD200	

NO REPRODUCTION IN FULL OR IN PART SHALL BE OBTAINED FROM THIS DOCUMENT WITHOUT THE WRITTEN CONSENT OF ITS OWNER.

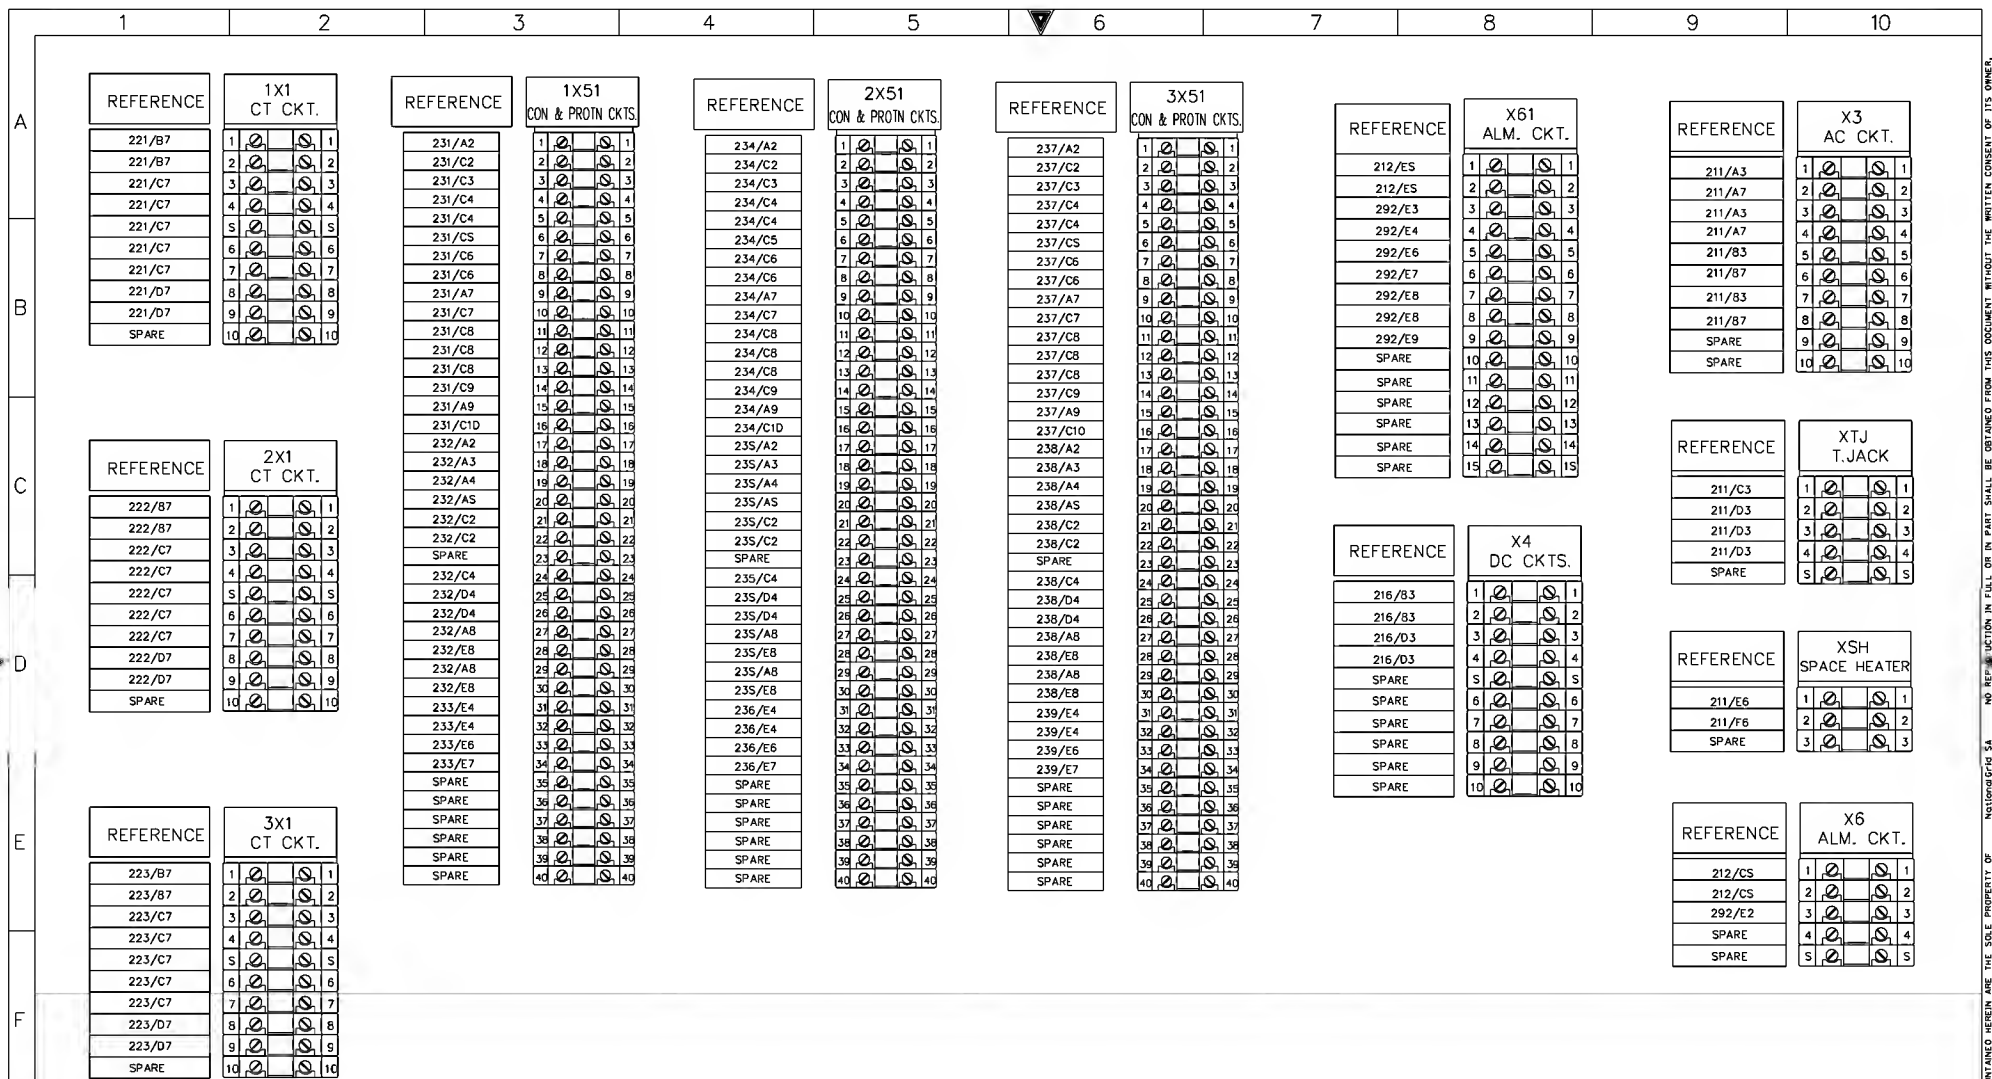

AS-BUILT BY _____ DATE _____ CONTRACT NO. 11131113/00 JOB ORDER NO. S-13656

01	13 49	FACTORY ASBUILT	DRAWN BY RIZ	CHECKED BY KVR
00	13 05	FOR APPROVAL	DATE STARTED 30.01.2013	DATE COMPLETED
REV. NO.	DATE	DESCRIPTION	OPRG. DEPT. CTPO	ENG. DEPT. AUT-PSAC

TERMINAL BLOCKS +BB2-5
132KV BUSBAR PROTIN.MAIN-2 BU PANEL +BBP2-5
S/S 8709 - 132/13.8KV IN AL-KHARJ CITY
RIYADH SAUDI ARABIA

الشركة الوطنية لنقل الكهرباء		نقل الكهرباء	
INDEX		DRAWING NUMBER	
PLANT NO.		SHEET NO.	
C421		CD-323009	
REV. NO.		SHT CONT.	
01		301/NIL	

NG/D2-0 (2012/01)
DMS VECTOR NGD200

THIS DRAWING AND THE INFORMATION CONTAINED HEREIN ARE THE SOLE PROPERTY OF NATIONAL GRID SA. NO REPRODUCTION IN FULL OR IN PART SHALL BE OBTAINED FROM THIS DOCUMENT WITHOUT THE WRITTEN CONSENT OF ITS OWNER.